

MARION

MISSISSIPPI BOARD OF WATER COMMISSIONERS

CODED

G 12
2-16-63

WATER WELL DRILLERS LOG

Date: 2-16, 1963, Driller: E. B. SHEPPARD County Marion
(Name)

(1) Owner of Land:	Description & Color of Materials Sand, Clay, Red Clay, Shell, etc.	Thick- ness Feet	Depth Feet
<u>Tom Robertson</u> (Name) <u>Rt 3 Columbia, Miss</u> (Address)	<u>RED CLAY</u>		<u>20</u>
(2) Location: $\frac{1}{4}$, $\frac{1}{4}$, Sec. <u>21</u> <u>N</u> <u>18</u> <u>3</u> miles <u>N. E.</u> of <u>COLUMBI</u> (distance) (direction) (Nearest Town) <u>MISS.</u>	<u>GRAVEL & SAND</u> <u>CLAY STREAKS</u> WATER SAND		<u>40</u> <u>60</u> <u>80</u> <u>100</u>
(3) Topography: <input checked="" type="checkbox"/> (Hilly) <input type="checkbox"/> (Flat) <input type="checkbox"/> (Level)			
(4) Purpose of Well: <u>Domestic</u> (Domestic Irrigation Municipal, Industrial, Other)	<u>CODED</u>		


Information upon completion of well:

- (1) Diameter 2 inches.
- (2) Total Depth 90 feet.
- (3) Water level 60 feet below top of ground.
- (4) Cased to _____, Size _____.
- (5) Screen: Size 2", Length 51.
- (6) Were any formations sealed against pollution?
_____ yes, _____ no.

If YES depth of formation _____

Why _____

Drillers Remarks: _____

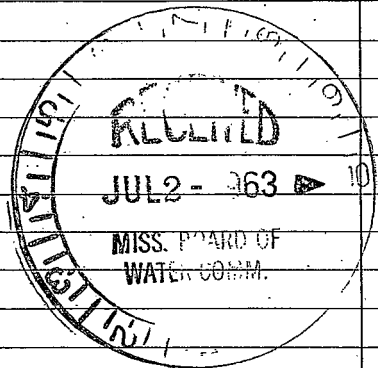

(Use Back Side)

Well No.

