

MARION MISSISSIPPI BOARD OF WATER COMMISSIONERS

CODED

JG 13
9-10-66

WATER WELL DRILLERS LOG

Date: 9-10, 1966 Driller: S.S. Rouse County _____

Joe Pittman
(Name)

(1) Owner of Land: JOE PITTMAN
(Name)
Rd 3 Columbus
(Address) 23 4-18

(2) Location: 1/4, 1/4, Sec. 36 T R
1 1/2 miles East of Rehoboth
(distance) (direction) (Nearest Town)

(3) Topography: _____
(Hilly) (Flat) (Level)

(4) Purpose of Well: Domestic
(Domestic Irrigation
Municipal, Industrial, Other)


Description & Color of Materials Sand, Clay, Red Clay, Shell, etc.	Thick- ness Feet	Depth Feet
<u>Red sand</u>	<u>60</u>	
<u>White clay</u>	<u>80</u>	
<u>Water sand</u>	<u>30</u>	
		<u>170</u>

Information upon completion of well:

- (1) Diameter 4 inches.
- (2) Total Depth _____ feet.
- (3) Water Level 85 feet below top of ground.
- (4) Cased to 162, Size 4.
- (5) Screen: Size 4, Length 8.
- (6) Were any formations sealed against pollution?
_____ yes, no.

If YES depth of formation _____
Why _____

Drillers Remarks: _____

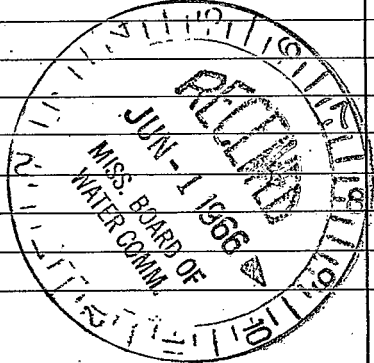

(Use Back Side)

Well No.

