

MARION  
RG 16  
12-30-61

WATER WELL DRILLERS LOG

On P?

Date: 12-30, 1961, Driller: DEAN PRINCE County MARION

(Name)

(1) Owner of Land: JABUS COOK  
 (Name)  
Route 2 Columbia, Miss.  
 (Address)

(2) Location: 30 4-18  
 $\frac{1}{4}$ ,  $\frac{1}{4}$ , Sec. T R  
8 miles S.E. of Columbia  
 (distance) (direction) (Nearest Town)

(3) Topography: X  
 (Hilly) (Flat) (Level)

(4) Purpose of Well: Domestic  
 (Domestic Irrigation  
 Municipal, Industrial, Other)

Description & Color of Materials Sand, Clay, Red Clay, Shell, etc.	Thick- ness Feet	Depth Feet
TOP SOIL	1'	1'
Red CLAY	10'	11'
CHALK	15'	26'
FINE SAND	25'	51'
Red CHALK	10'	61'
COARSE SAND	19'	80'

Information upon completion of well:

(1) Diameter 2 inches.

(2) Total Depth 80 feet.

(3) Water Level 40 feet below top of ground.


(4) Cased to 75', Size 2"

(5) Screen: Size 2", Length 5'

(6) Were any formations sealed against pollution?  
   yes, X no.

CODED

If YES depth of formation \_\_\_\_\_  
 Why \_\_\_\_\_  
 Drillers Remarks: \_\_\_\_\_

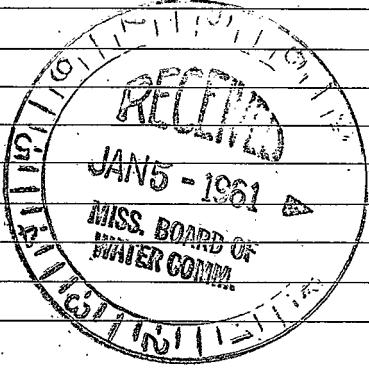

Well No.

(Use Back Side)

