

Marion
G 19
12-22-69

MISSISSIPPI
BOARD OF WATER COMMISSIONERS
416 North State Street
Jackson, Mississippi 39201

CODED

WATER WELL DRILLERS LOG

12/22 1969 Dean Griner Marion
date well completed firm name county well located

LANDOWNER:

Olga Brewster

description of formations encountered

from to

Route 4 Columbia, Miss
(mailing address)

top soil 0-1

WELL LOCATION:

sec. 6 T. 4 N. R. 18 E.
S. W.
6 miles N of Columbia
(distance) (direction) (nearest town)

red clay 1-10

red sand 10-20

Gravel 20-70

WELL PURPOSE: Home Use
(home, irrigation, municipal, industrial)

WELL COMPLETION DATA:

(1) diameter (inches) 2"

(2) total depth (feet) 130'

(3) static water level (feet) 50' below top of ground.

(4) casing Plastic, 118
(material) (depth)

_____ if telescope see back.
(size)

(5) screen 10 120'
(length) (depth to top)

2" Plastic
(size) (material)

(6) pump 1/4
(HP) (yield gpm)

Reith Berry jet pump
(type of pump)

(7) electric log No
(yes or no)

_____ (organization running log)

(8) how well bottom plugged _____

description of formations encountered	from	to
top soil	0	1
red clay	1	10
red sand	10	20
Gravel	20	70
fine sand	70	100
water sand & gravel	100	130

CODED


MAR 18 1970

MISS. BD. OF
WATER COMM.

DRILLERS REMARKS:

If well telescopes please sketch and show depths.

GROUND LEVEL

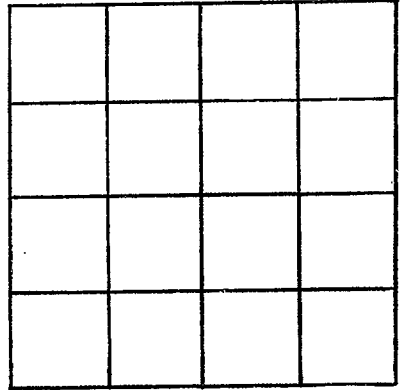

SECTION _____

Please indicate well location X.

ADDITIONAL INFORMATION

If more than one screen, show locations of each on sketch.