

MARION
G 20
1-70

MISSISSIPPI
BOARD OF WATER COMMISSIONERS
416 North State Street
Jackson, Mississippi 39201

CODED

WATER WELL DRILLERS LOG

JAN. 1970 E. B. Sheward Marion
date well completed: firm name county/well located

LANDOWNER: C. D. Truery
Columbia, Miss.
(mailing address)

description of formations encountered	from	to
RED SANDY CLAY	0	60
SMALL WHITE WATER SAND	60	86

WELL LOCATION:
sec. 13 T 4 N R 18 E
6 miles NE of Columbia
(distance) (direction) (nearest town)

WELL PURPOSE:
(home, irrigation, municipal, industrial)

- WELL COMPLETION DATA:
- (1) diameter (inches) 2"
 - (2) total depth (feet) 86'
 - (3) static water level (feet) 66' below top of ground.
 - (4) casing (material) (depth) Plastic, 86'
 - 2" (size) if telescope see back.
 - (5) screen 3' (length) (depth to top)
 - 2 1/2" (size) (material) S.S.
 - (6) pump 3/4 (HP) 6 (yield gpm)
 - (type power)
 - (7) electric log (yes or no) (no)
 - (organization running log)
 - (8) how well bottom plugged BN

CODED


FEB 5 - 1970

DRILLERS REMARKS:

MISSISSIPPI BOARD OF WATER COMMISSIONERS

If well telescopes please sketch and show depths.

GROUND LEVEL

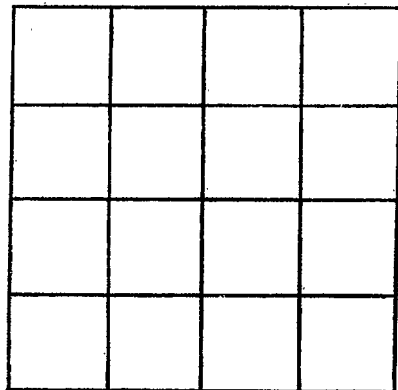

SECTION _____

Please indicate well location X.

ADDITIONAL INFORMATION

If more than one screen, show locations of each on sketch.