

MISSISSIPPI
 BOARD OF WATER COMMISSIONERS
 416 North State Street
 Jackson, Mississippi 39201

CODED

WATER WELL DRILLERS LOG

Marion
 G 21
 2-70

February 1970 E.B. Sherard Marion
 date well completed firm name county well located

LANDOWNER:

Mrs. Jaye Brown
 Rt. 3, Columbia, Miss.
 (mailing address)

description of formations encountered

from to

RED SANDY
 CLAY
 STREAKS OF
 GRAVEL
 SAND & PEACH 0 60
 60 78

WELL LOCATION:

sec. 12 T. 4 N R. 18 E
 6 miles NE of Columbia
 (distance) (direction) (nearest town)

WELL PURPOSE:

(home) Irrigation, municipal, industrial)

WELL COMPLETION DATA:

- (1) diameter (inches) 2"
- (2) total depth (feet) 78
- (3) static water level (feet) 64 below top of ground.
- (4) casing (material) 78 (depth)
 2" (size) if telescope see back.
- (5) screen 3' (length) (depth to top)
 2 1/2" S.S. (size) (material)
- (6) pump 3/4 (HP) 6 (yield gpm)
 E (type power)
- (7) electric log (yes or no)
- (organization running log)
- (8) how well bottom plugged B.W.V

CODED


MAR 17 1970

DRILLERS REMARKS:

MISS. BD. OF
 WATER COMM.

If well telescopes please sketch and show depths.

GROUND LEVEL

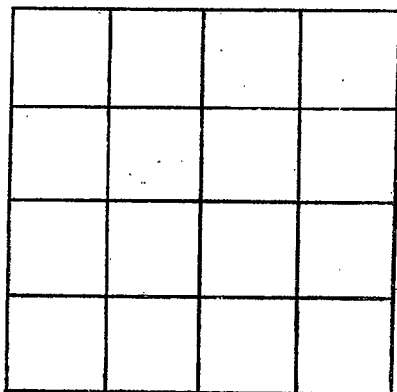

SECTION _____

Please indicate well location X.

ADDITIONAL INFORMATION

If more than one screen,
show locations of each on sketch.