

MARION  
G22  
7-70

MISSISSIPPI  
BOARD OF WATER COMMISSIONERS  
416 North State Street  
Jackson, Mississippi 39201

CODED

WATER WELL DRILLERS LOG

July  
date well completed

1970 E.B. SHEPPARD  
firm name

MARION  
county well located

LANDOWNER:

JEWELINE KELLY

Rt. 4 - Columbia, Miss.  
(mailing address)

description of formations  
encountered

BROWNISH CLAY

GRAY CLAY

FINE SAND

WHITE COARSE SAND

from

to

0 28

28 35

35 40

40 48

WELL LOCATION:

sec. 6 T. 4 N R. 18 E  
5 miles N of Columbia  
(distance) (direction) (nearest town)

WELL PURPOSE:

~~Home~~ irrigation, municipal, industrial

WELL COMPLETION DATA:

- (1) diameter (inches) 2"  
(2) total depth (feet) 48  
(3) static water level (feet) 33 below  
top of ground.  
(4) casing PLASTIC, 43',  
(material) (depth)  
2" if telescope see back.  
(size)  
(5) screen 3',  
(length) (depth to top)  
2", S.S.  
(size) (material)  
(6) pump 3/4 7  
(HP) (yield gpm)  
E  
(type power)  
(7) electric log (yes or no)  
(organization running log)  
(8) how well bottom plugged BWV.

CODED


AUG 13 1970

DRILLERS REMARKS:

MISS. BD. OF  
WATER COM.

If well telescopes please sketch and show depths.

GROUND LEVEL

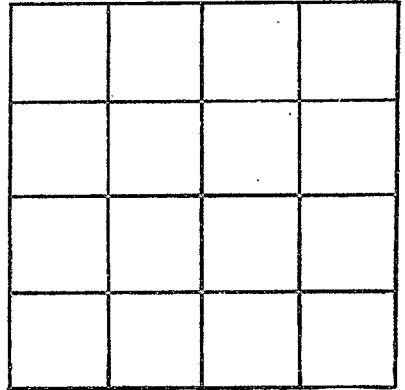

SECTION \_\_\_\_\_

Please indicate well location X.

ADDITIONAL INFORMATION

If more than one screen, show locations of each on sketch.