

Marion
G-23
7-71

MISSISSIPPI
BOARD OF WATER COMMISSIONERS
416 North State Street
Jackson, Mississippi 39201

WATER WELL DRILLERS LOG

CODED

July 1971 E.B. SHERARD MARION
date well completed firm name county well located

LANDOWNER:

JOHN LUTER

Rt. 4 Columbia
(mailing address)

WELL LOCATION:

sec. 6 T. 4_S N R. 18 E W
4 miles N of Columbia
(distance) (direction) (nearest town)

WELL PURPOSE:

(home) Irrigation, municipal, industrial

WELL COMPLETION DATA:

- (1) diameter (inches) 2"
(2) total depth (feet) 26.5
(3) static water level (feet) 80 below above top of ground.
(4) casing PL, 260,
(material) (depth)
2" if telescope see back.
(size)
(5) screen 5',
(length) (depth to top)
2", PL
(size) (material)
(6) pump 3/4, 6
(HP) (yield gpm)
E
(type power)
(7) electric log _____
(yes or no)

(organization running log)
(8) how well bottom plugged BWV

description of formations encountered

from to

BED SANDY CLAY	0	20
GRAVEL	20	26
BLUE CLAY	26	230
COARSE GRAY SAND		
↓ FINE GRAVEL	230	265

CODED


SEP 15 1971

MISS. BD. OF
WATER COMM.

DRILLERS REMARKS:

If well telescopes please sketch and show depths.

GROUND LEVEL

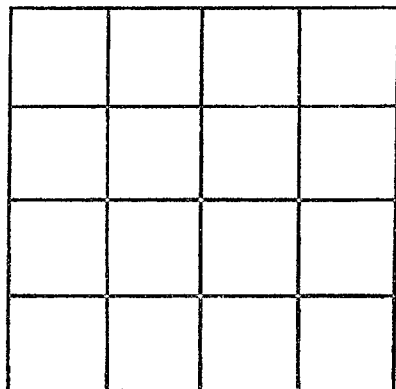

SECTION _____

Please indicate well location X.

ADDITIONAL INFORMATION

If more than one screen, show locations of each on sketch.