

MARION
G24
1-25-71

MISSISSIPPI
 BOARD OF WATER COMMISSIONERS
 416 North State Street
 Jackson, Mississippi 39201

CODED

WATER WELL DRILLERS LOG

1-25-71 date well completed Dean Spinerwell Service firm name Marion county well located

LANDOWNER:
 Emery Pope
 Route 5 Columbia, Miss.
 (mailing address)

description of formations encountered	from	to
top soil	0	1
Chalk	1	22

WELL LOCATION:
 sec. 8 T 4 N R 18 E
 S W
 10 miles North of Columbia
 (distance) (direction) (nearest town)

fine sand	22	60
water sand	60	86

WELL PURPOSE: house well
 (home, irrigation, municipal, industrial)

- WELL COMPLETION DATA:**
- (1) diameter (inches) 2"
 - (2) total depth (feet) 86'
 - (3) static water level (feet) 26 below above top of ground.
 - (4) casing Galv Pipe 80'
 (material) (depth)
 (size) if telescope see back.
 - (5) screen 4' 83
 (length) (depth to top)
2" S.S. strainer
 (size) (material)
 - (6) pump _____ (HP) _____ (yield gpm)
 (type power)
 - (7) electric log _____ (yes or no)
 (organization running log)
 - (8) how well bottom plugged _____

CODED


OCT 21 1971

DRILLERS REMARKS:

MISS. BD. OF
 WATER COMM.

If well telescopes please sketch and show depths.

GROUND LEVEL

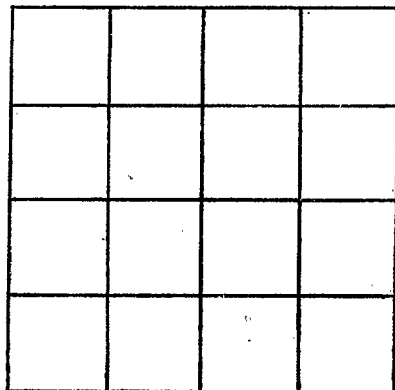

SECTION _____

Please indicate well location X.

ADDITIONAL INFORMATION

If more than one screen,
show locations of each on sketch.