

MARION  
G28  
6-72

MISSISSIPPI  
BOARD OF WATER COMMISSIONERS  
416 North State Street  
Jackson, Mississippi 39201

WATER WELL DRILLERS LOG

**CODED**

June 1972 E.B. Shucard Marion  
(date well completed) (firm name) (county well located)

LANDOWNER:  
Nelson Williams  
Columbia Miss.  
(mailing address)

description of formations encountered  
from to  
RED CLAY 0 20  
SAND & GRAVEL 20 38

WELL LOCATION:  
sec. 20 T. 4 N. R. 18 E.  
2 miles W of Columbia  
(distance) (direction) (nearest town)

WELL PURPOSE:  
Home, irrigation, municipal, industrial)


- WELL COMPLETION DATA:
- (1) diameter (inches) 4"
  - (2) total depth (feet) 38'
  - (3) static water level (feet) 24 below above top of ground.
  - (4) casing pl. 28'  
(material) (depth)  
4" if telescope see back.  
(size)
  - (5) screen 10' pl.  
(length) (depth to top)  
4" pl.  
(size) (material)
  - (6) pump 3/4 sub. 10  
(HP) (yield gpm)  
E  
(type power)
  - (7) electric log (yes or no)  
(organization running log)
  - (8) how well bottom plugged BWV

**CODED**


JUL 28 1972

DRILLERS REMARKS:

If well telescopes please sketch and show depths.

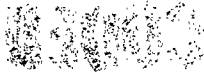

GROUND LEVEL

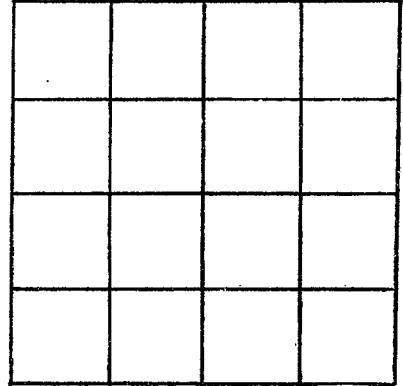

SECTION \_\_\_\_\_

Please indicate well location X.

ADDITIONAL INFORMATION

A series of horizontal lines providing space for additional information, starting below the 'ADDITIONAL INFORMATION' header and extending to the bottom of the page.

If more than one screen, show locations of each on sketch.