

MARION
G 29
6-72

MISSISSIPPI
 BOARD OF WATER COMMISSIONERS
 416 North State Street
 Jackson, Mississippi 39201

WATER WELL DRILLERS LOG

June 1972 E.B. Sheppard Marion
 date well completed firm name county well located

LANDOWNER:

Warren King
Rt. 4 - Columbia, Miss.
 (mailing address)

description of formations encountered

from to

SAND & CLAY
MIXED
CLAY & CLAY
PEA GR. & SAND
 0 25
 25 75
 75 123

WELL LOCATION:

sec. 6.4 N R 18 E
4 miles W of Columbia
 (distance) (direction) (nearest town)

WELL PURPOSE:

(home) irrigation, municipal, industrial

WELL COMPLETION DATA:

- (1) diameter (inches) 2"
- (2) total depth (feet) 123'
- (3) static water level (feet) 60' below above top of ground.
- (4) casing pl. 118'
 (material) (depth)
2" if telescope see back.
 (size)
- (5) screen 5'
 (length) (depth to top)
2" pl.
 (size) (material)
- (6) pump 1 7
 (HP) (yield gpm)
E
 (type power)
- (7) electric log (yes or no)

(organization running log)

(8) how well bottom plugged BWR

CODED


20 1072

SEEK 8-
 WATER CU-

DRILLERS REMARKS:

If well telescopes please sketch and show depths.

GROUND LEVEL

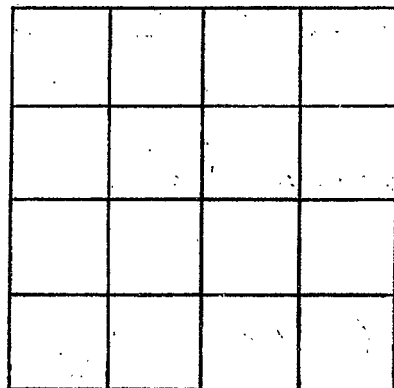

SECTION _____

Please indicate well location X.

ADDITIONAL INFORMATION

If more than one screen, show locations of each on sketch.