

MARION
G 30
4-72

MISSISSIPPI
BOARD OF WATER COMMISSIONERS
416 North State Street
Jackson, Mississippi 39201

CODED

WATER WELL DRILLERS LOG

April 1972 E.B. Sheppard Marion
date well completed firm name county well located

LANDOWNER:

J. E. Lucas

Rt. 3, Columbia, Miss.
(mailing address)

WELL LOCATION:

sec. 9 T. 4 N. R. 18 E.
4 miles N of Columbia
(distance) (direction) (nearest town)

WELL PURPOSE:

(home irrigation, municipal, industrial)

WELL COMPLETION DATA:

- (1) diameter (inches) 2"
- (2) total depth (feet) 380'
- (3) static water level (feet) 78' below above top of ground.
- (4) casing pl. 370' (material) (depth)
2" (size) if telescope see back.
- (5) screen 10' (length) (depth to top)
2" (size) pl. (material)
- (6) pump 1 (HP) 7 (yield gpm)
E (type power)
- (7) electric log (yes or no)

(organization running log)

- (8) how well bottom plugged BLW

description of formations encountered

	from	to
SANDY RED CLAY	0	40
BLUE CLAY	40	280
FINE SAND	280	350
COARSE SAND WITH LITTLE P. GA.	350	380

CODED


DRILLERS REMARKS:

MISS. 2.6 1972

MISS. Bd. of
WATER COMM.

If well telescopes please sketch and show depths.

GROUND LEVEL

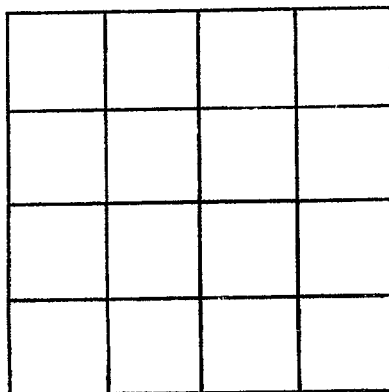

SECTION _____

Please indicate well location X.

ADDITIONAL INFORMATION

If more than one screen, show locations of each on sketch.