

MARION
G 33
2-73

MISSISSIPPI
BOARD OF WATER COMMISSIONERS
416 North State Street
Jackson, Mississippi 39201

CODED

WATER WELL DRILLERS LOG

Feb. 73 E. B. Sheppard Marion
date well completed firm name county well located

LANDOWNER:

Clark Dial
Columbia, Miss.
(mailing address)

description of formations encountered

description of formations encountered	from	to
SANDY GRAY CLAY	0	30'
SMALL SAND	30'	70'
DE A GR SAND	70'	95'

WELL LOCATION:

sec. 33 T 4 N R 18 E
S W
 $\frac{1}{2}$ miles E of Columbia
(distance) (direction) (nearest town)

WELL PURPOSE:

(home, irrigation, municipal, industrial)

WELL COMPLETION DATA:

- (1) diameter (inches) 4"
- (2) total depth (feet) 95'
- (3) static water level (feet) 35 below above top of ground.
- (4) casing pl. 95' (material) (depth)
4" (size) If telescope see back.
- (5) screen 10' (length) (depth to top)
4" (size) pl. (material)
- (6) pump $\frac{1}{2}$ (HP) 15 (yield gpm)
E (type power)
- (7) electric log (yes or no)

CODED


(organization running log)

(8) how well bottom plugged BWV

DRILLERS REMARKS:

If well telescopes please sketch and show depths.

GROUND LEVEL

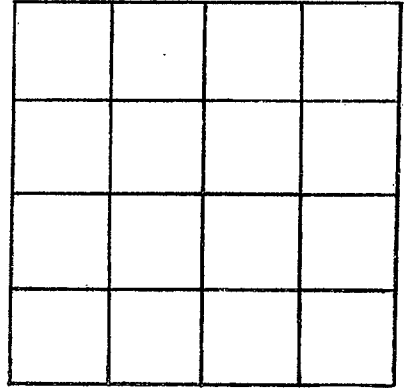

SECTION _____

Please indicate well location X.

ADDITIONAL INFORMATION

If more than one screen,
show locations of each on sketch.