

MARION  
G 35  
6-73

MISSISSIPPI  
BOARD OF WATER COMMISSIONERS  
416 North State Street  
Jackson, Mississippi 39201  
WATER WELL DRILLERS LOG

CODED

JUNE 1973  
date well completed

E. B. SHERRARD  
firm name

MARION  
county well located

LANDOWNER:

Tom SPEIGHTS  
COLUMBIA, Miss.  
(mailing address)

description of formations  
encountered

from to

GRAVEL CLAY 0 60'  
STR. CLAY  
CLAY & FINE  
SAND 60-90'  
REA GR & COARSE SAND 90-107'

WELL LOCATION:

sec 10 T 4 N R 18 E  
S  
5 miles N Columbia  
(distance) (direction) (nearest town)

WELL PURPOSE:

(home, irrigation, municipal, industrial)

WELL COMPLETION DATA:

- (1) diameter (inches) 2"
- (2) total depth (feet) 107'
- (3) static water level (feet) 58' <sup>below</sup> <sub>above</sub> top of ground.
- (4) casing pl. 102' (material) (depth)  
2" (size) if telescope see back.
- (5) screen 5' (length) (depth to top)  
2" (size) pl. (material)
- (6) pump 1 (HP) 7 (yield gpm)  
E (type power)
- (7) electric log ~~yes~~ (no)

(organization running log)

(8) how well bottom plugged BWV

CODED


OCT 10 1973

DRILLERS REMARKS:

MISS. BD. OF  
WATER COM.

If well telescopes please sketch and show depths.

GROUND LEVEL

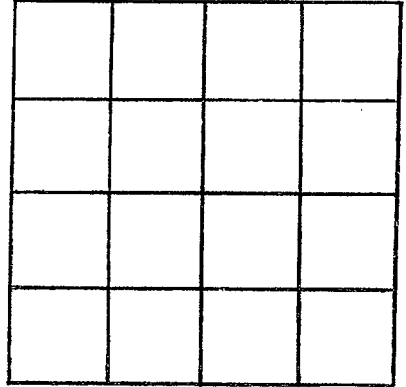

SECTION \_\_\_\_\_

Please indicate well location X.

ADDITIONAL INFORMATION

If more than one screen,  
show locations of each on sketch.