

MARION
G36
4-2-73

MISSISSIPPI
BOARD OF WATER COMMISSIONERS
416 North State Street
Jackson, Mississippi 39201

CODED

WATER WELL DRILLERS LOG

4/12/73 Gunter-Gunn Marion
date well completed firm name county well located

LANDOWNER:

Bennie Barker

(mailing address)

WELL LOCATION:

sec. 27 T 4 N R 18 E
W
miles of
(distance) (direction) (nearest town)

WELL PURPOSE:

Home
(home, irrigation, municipal, industrial)

WELL COMPLETION DATA:

- (1) diameter (inches) 4"
- (2) total depth (feet) 105'
- (3) static water level (feet) 55' below, above top of ground
- (4) casing Plastic 95'
(material) (depth)
4" if telescope see back.
(size)
- (5) screen 10' —
(length) (depth to top)
plastic
(size) (material)
- (6) pump 1/2 HP 10
(HP) (yield gpm)
elec.
(type power)
- (7) electric log No
(yes or no)
- (organization running log)

description of formations encountered

~~Gravel~~
TOP Soil 0 4"
Gravel 4" 39"
Clay 39 80"
Gravel 80 105"


COVERED

DRILLERS REMARKS:

MISS. BU
WATER

If well telescopes please
sketch and show depths.

GROUND LEVEL

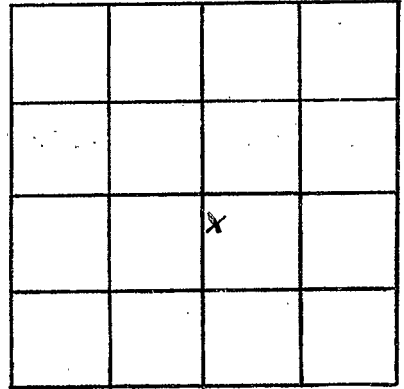

SECTION 27

Please indicate well location X.

ADDITIONAL INFORMATION

If more than one screen,
show locations of each on sketch.