

MARION
G 37
8/73

MISSISSIPPI
BOARD OF WATER COMMISSIONERS
416 North State Street
Jackson, Mississippi 39201

CODED


WATER WELL DRILLERS LOG

Aug. 19 73 E. B. Sheppard Marion
date well completed firm name county well located

LANDOWNER:	description of formations encountered	from	to
Ross Brown	GRAY CLAY	0	25
14.4 - Columbia, Mo. (mailing address)	SAND + GR.	25	55
WELL LOCATION:			
sec 20 T. 4 N R 18 E S S E 1 miles N of Columbia (distance) (direction) (nearest town)			
WELL PURPOSE: (Home, Irrigation, municipal, industrial)			
WELL COMPLETION DATA:			
(1) diameter (inches) 2"			
(2) total depth (feet) 55			
(3) static water level (feet) 30 below top of ground.			
(4) casing phi. 50' (material) (depth) 2" (size) if telescope see back.			
(5) screen 5' (length) (depth to top) 2" (size) phi. (material)			
(6) pump 1 (HP) 7 (yield gpm) E (type power)			
(7) electric log (yes or no)			
(organization running log)			
(8) how well bottom plugged BWV			
DRILLERS REMARKS:			
FEB			
MISS. BD. OF WATER COMMISSIONERS			

If well telescopes use
sketch and show 15.

GROUND LEVEL

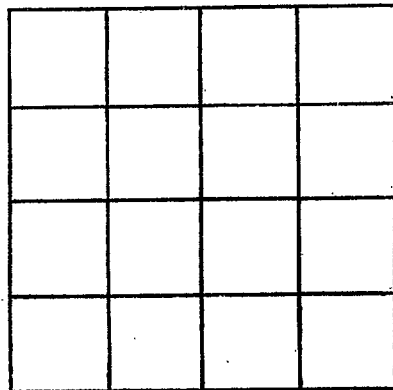

SECTION _____

Please indicate well location X.

ADDITIONAL INFORMATION

If more than one screen,
show locations of each on sketch.