

MARION
G 40
4-15-79

MISSISSIPPI
BOARD OF WATER COMMISSIONERS
416 North State Street
Jackson, Mississippi 39201

CODED

WATER WELL DRILLERS LOG

4-15 1974
date well completed

GRINER - GINN
firm name

Marion
county well located

LANDOWNER:	description of formations encountered	from	to
Some Anderson Rt. Columbia, Miss. (mailing address)			
WELL LOCATION: sec. 27 T. 4 S. R. 18 E. 1 miles N.E. of Columbia (distance) (direction) (nearest town)			
WELL PURPOSE: (home, irrigation, municipal, industrial)			
WELL COMPLETION DATA:			
(1) diameter (inches) 2"			
(2) total depth (feet) 110'			
(3) static water level (feet) 50' below top of ground.			
(4) casing plastic, 100' (material) (depth) 2" (size) if telescope see back.			
(5) screen 10' (length), 100' (depth to top) 2" (size), plastic (material)			
(6) pump 1 (HP), 6 (yield gpm) Elec. (type power)			
(7) electric log No (yes or no) No (organization-running log)			
(8) how well bottom plugged B.W. Valve			
DRILLERS REMARKS:			


CODED

DECLARATION
MAY 9 1974

MISSISSIPPI BOARD OF WATER COMMISSIONERS

If well telescopes please sketch and show depths.

GROUND LEVEL

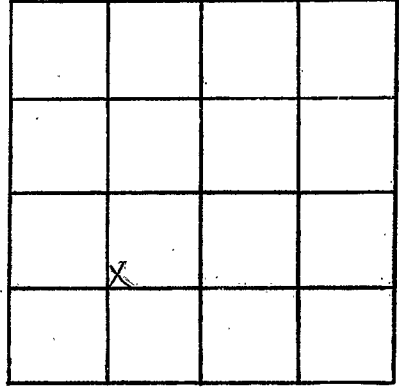

SECTION 27

Please indicate well location X.

ADDITIONAL INFORMATION

If more than one screen, show locations of each on sketch.