

MARION  
G41  
3/74

MISSISSIPPI  
BOARD OF WATER COMMISSIONERS  
416 North State Street  
Jackson, Mississippi 39201

CODED


WATER WELL DRILLERS LOG

March 1974 E.B. Sherrard Marion  
date well completed firm name county well located

| LANDOWNER:  | description of formations encountered                        | from | to         |
|---|--|------|------------|
| Arthur Fastenberry<br>Rt 4 - Columbia, Miss.<br>(mailing address)   | RED SANDY CLAY<br>SAND + RED CL.                             | 0    | 42'<br>76' |
| <p>WELL LOCATION:</p> <p>sec 20 T 4 N R 18 E<br/>S W</p> <p>1 miles N Columbia<br/>(distance) (direction) (nearest town)</p>  | CODED  |      |            |
| <p>WELL PURPOSE:</p> <p>(home) irrigation, municipal, industrial</p>  |  |      |            |
| <p>WELL COMPLETION DATA:</p> <p>(1) diameter (inches) 2"</p> <p>(2) total depth (feet) 76'</p> <p>(3) static water level (feet) 48' below above top of ground.</p> <p>(4) casing pl. 71' (material) (depth)<br/>2" if telescope see back. (size)</p> <p>(5) screen 5' (length) (depth to top)<br/>2" pl. (size) (material)</p> <p>(6) pump 3/4 8 (HP) (yield gpm)<br/>E (type power)</p> <p>(7) electric log (yes or no)</p> <p>(organization running log)</p> <p>(8) how well bottom plugged BWV</p> | <p>RECEIVED<br/>MIL - 1 1974<br/>MISS. BD. OF WATER COMM</p> |      |            |
| <p>DRILLERS REMARKS:</p>  |  |      |            |

If well telescopes please sketch and show depths.

GROUND LEVEL

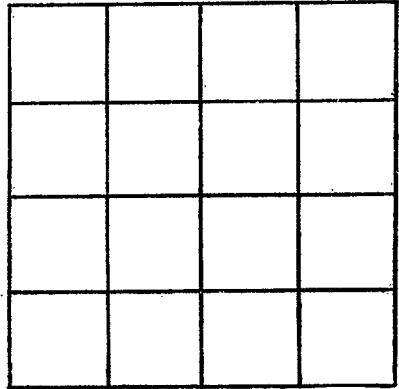

SECTION \_\_\_\_\_

Please indicate well location X.

ADDITIONAL INFORMATION

If more than one screen, show locations of each on sketch.