

MARION
G 92
3/74

MISSISSIPPI
BOARD OF WATER COMMISSIONERS
416 North State Street
Jackson, Mississippi 39201 CODED

WATER WELL DRILLERS LOG

March 24 1974 E.B. Sheppard Marion
date well completed firm name county well located

LANDOWNER:
Kenneth Pittman
Pt. 4 Columbia, Miss.
(mailing address)


description of fomations encountered		from	to
RED SANDY CLAY GR.		0	40'
SAND & PEA GR.		40'	74'

WELL LOCATION:
sec 20 T 4 N R 18 E
S W
1 miles N Columbia
(distance) (direction) (nearest town)

CODED

WELL PURPOSE:
(home) Irrigation, municipal, industrial

- WELL COMPLETION DATA:
- (1) diameter (inches) 2"
 - (2) total depth (feet) 74'
 - (3) static water level (feet) 46' below top of ground.
 - (4) casing pl. 69' (material) (depth)
2" (size) if telescope see back.
 - (5) screen 5' (length) (depth to top)
2" (size) pl. (material)
 - (6) pump 1 (HP) 7 (yield gpm)
E (type power)
 - (7) electric log (yes or no)
 - (organization running log)
 - (8) how well bottom plugged BWV

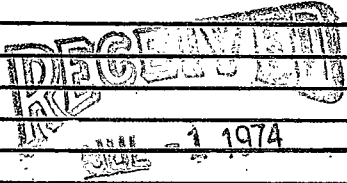

DRILLERS REMARKS:

MISS. Bd. OF WATER COMM.

