

MARION  
G43  
2/74

MISSISSIPPI  
BOARD OF WATER COMMISSIONERS  
416 North State Street  
Jackson, Mississippi 39201

WATER WELL DRILLERS LOG CODED

Feb. 1974 E.B. Sheward Marion  
date well completed firm name county well located

LANDOWNER:	description of formations encountered	from	to
Kemp Pittman Rt. 3 - Columbia, Miss. (mailing address)	SAND + GRAY CLAY MIXED SAND + LEA CK.	0	60 85
<b>WELL LOCATION:</b>			
sec 33 T 4 N R 18 E 1/2 miles E of Columbia (distance) (direction) (nearest town)			
<b>WELL PURPOSE:</b>			
(home, irrigation, municipal, industrial)			
<b>WELL COMPLETION DATA:</b>			
(1) diameter (inches) 2"			
(2) total depth (feet) 85'			
(3) static water level (feet) 48' below top of ground.			
(4) casing pl. 80' (material) (depth) 2" (size) if telescope see back.			
(5) screen 5' (length) (depth to top)			
(6) pump 3/4 8 (HP) (yield gpm) E (type power)			
(7) electric log (yes or no) (organization running log)			
(8) how well bottom plugged B.W.V.			
<b>DRILLERS REMARKS:</b>			


CODED

RECEIVED  
JUL 1 1974

MISS. Bd. OF WATER COMMISSIONERS

If well telescopes please sketch and show depths.

GROUND LEVEL

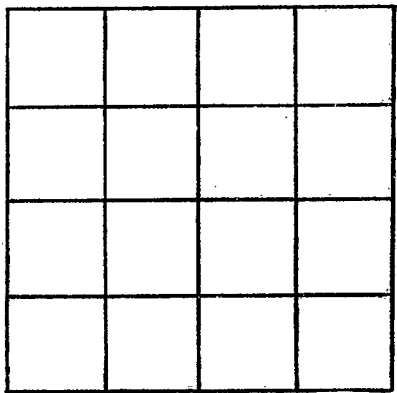

SECTION \_\_\_\_\_

Please indicate well location X.

ADDITIONAL INFORMATION

A series of horizontal lines for recording additional information.

If more than one screen, show locations of each on sketch.