

Marion
G 44
11/74

MISSISSIPPI
BOARD OF WATER COMMISSIONERS
416 North State Street
Jackson, Mississippi 39201

WATER WELL DRILLERS LOG

CODED

Nov. 1974 E.B. Sheppard Marion
date well completed firm name county well located

LANDOWNER:

Mr. Virgil Telech
Rt. 3 - Columbia, Ms.
(mailing address)

description of formations encountered

from to

GRAY CHALK	0	60'
FINE SAND	60'	85'
COARSE SAND MIXED WITH SEA SH.	85'	120'

WELL LOCATION:

sec. 4 T 4 N R 18 E
S W
4 1/2 miles N Columbia
(distance) (direction) (nearest town)

WELL PURPOSE:

(home) irrigation, municipal, industrial

WELL COMPLETION DATA:

- (1) diameter (inches) 8 1/2"
- (2) total depth (feet) 120'
- (3) static water level (feet) 55' below top of ground.
- (4) casing pl. 110' (material) (depth)
4" (size) if telescope see back.
- (5) screen 10' (length) (depth to top)
4" (size) pl. (material)
- (6) pump 3/4 sub. 20 (HP) (yield gpm)
E (type power)
- (7) electric log (yes or no) (yes)

(organization running log)


(8) how well bottom plugged B.W.V.

DRILLERS REMARKS:

RECEIVED
MAY - 8 1975

If well telescopes please sketch and show depths.

GROUND LEVEL

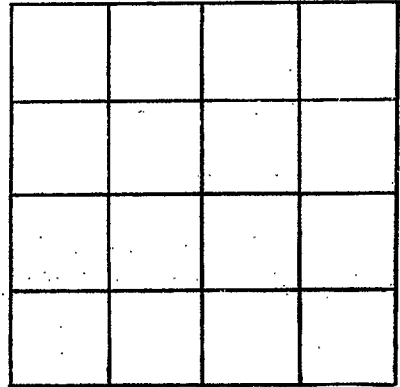

SECTION _____

Please indicate well location X.

ADDITIONAL INFORMATION

Lined area for additional information, consisting of approximately 20 horizontal lines.

If more than one screen, show locations of each on sketch.