

Marion  
G 45  
12/74

MISSISSIPPI  
BOARD OF WATER COMMISSIONERS  
416 North State Street  
Jackson, Mississippi 39201

CODED

WATER WELL DRILLERS LOG

Dec. 1974 E.B. Sherrard Marion  
date well completed firm name county well located

LANDOWNER:  
F. E. Monroe  
Columbia, Ms.  
(mailing address)

description of formations encountered	from	to
GRAY SANDY CLAY	0	28'
FINE SAND	28	50'
COARSE PEA GR. SAND	50'	80'

WELL LOCATION:  
sec. 33 T 4 N R 18 E  
S 5  
1 miles e of Columbia  
(distance) (direction) (nearest town)

WELL PURPOSE:  
(home) irrigation, municipal, industrial


- WELL COMPLETION DATA:
- (1) diameter (inches) 2"
  - (2) total depth (feet) 80
  - (3) static water level (feet) 40' below above top of ground.
  - (4) casing pl. 75' (material) (depth)  
2" (size) if telescope see back.
  - (5) screen 5' (length) (depth to top)  
2" (size) pl. (material)
  - (6) pump 1 (HP) 8 (yield gpm)  
e (type power)
  - (7) electric log (yes or no)
  - (8) how well bottom plugged BWV

DRILLERS REMARKS:

RECEIVED  
MAY - 8 1975

If well telescopes please sketch and show depths.

GROUND LEVEL

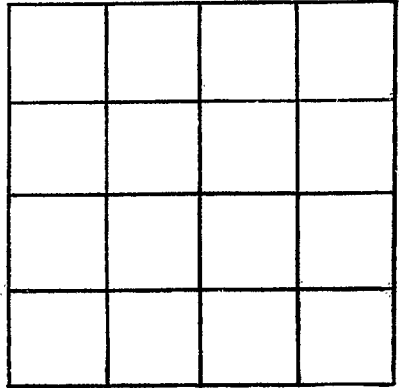

SECTION \_\_\_\_\_

Please indicate well location X.

ADDITIONAL INFORMATION

If more than one screen, show locations of each on sketch.