

Marion
 548
 10-6-79

MISSISSIPPI
 BOARD OF WATER COMMISSIONERS
 416 North State Street
 Jackson, Mississippi 39201

CODED

WATER WELL DRILLERS LOG

10-6-79 Griner Drilling Marion
 date well completed firm name county well located

LANDOWNER:
 First Energy Corporation
 P.O. Box 12710
 Jackson, Ms.
 (mailing address)

description of formations encountered	from	to
chalk	0	94
sand + pea gravel	94	378

WELL LOCATION: 1500' N + 1500' W of
 Cedar Grove T 40 R 18 E S 40 of
 North of Columbia
 (distance) (direction) (nearest town)

WELL PURPOSE: oil field supply
 (home, irrigation, municipal, industrial)

WELL COMPLETION DATA:

- diameter (inches) 3"
- total depth (feet) 378'
- static water level (feet) 70' ^{below} _{above} top of ground.
- casing steel, 378'
(material) (depth)
3"
(size) If telescope see back.
- screen 42, 336'
(length) (depth to top)
3", perforated
(size) (material)
- pump AC, 70
(HP) (yield gpm)
(type power)
- electric log
(yes or no)

(organization running log)

(8) how well bottom plugged orange
peel

DRILLERS REMARKS:


DEPT. OF NATURAL RESOURCES
 BUREAU OF LAND & WATER RESOURCES

NOV 13 1979

RECEIVED

If well telescopes please sketch and show depths.

GROUND LEVEL

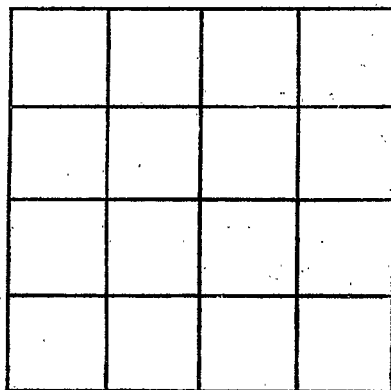

SECTION _____

Please indicate well location X.

ADDITIONAL INFORMATION

If more than one screen, show locations of each on sketch.