

MARION
G-49
1-25-80

MISSISSIPPI
BOARD OF WATER COMMISSIONERS
416 North State Street
Jackson, Mississippi 39201

CODED

WATER WELL DRILLERS LOG

1-25-80 Griner Drilling Marion

date well completed

firm name

county well located

LANDOWNER:
Champion Petroleum
P.O. Box 310
Carthage, TX 75633
(mailing address)

description of formations encountered	from	to
sand gravel	0	30
chalk	30	84
sand gravel	84	420

WELL LOCATION: NE SE 1480' N
SEC 6 T 4 N R 18 E 1140' W
Crownwell
Zellerbach
#1
Expos miles of SE/CO

WELL PURPOSE: oil field supply
(home, irrigation, municipal, industrial)

WELL COMPLETION DATA:

- (1) diameter (inches) 4"
- (2) total depth (feet) 420'
- (3) static water level (feet) 80' below top of ground.
- (4) casing steel 420' (material) (depth)
4" (size) if telescope see back.
- (5) screen 42' 378' (length) (depth to top)
4" perforated (size) (material)
- (6) pump - 80 (HP) (yield gpm)
AC (type power)
- (7) electric log (yes or no)

CODED

(organization running log)

(8) how well bottom plugged Diange
peel

DRILLERS REMARKS:


DEPT. OF NATURAL RESOURCES
BUREAU OF LAND & WATER RESOURCES

FEB - 7 1980

RECEIVED

If well telescopes please sketch and show depths.

GROUND LEVEL

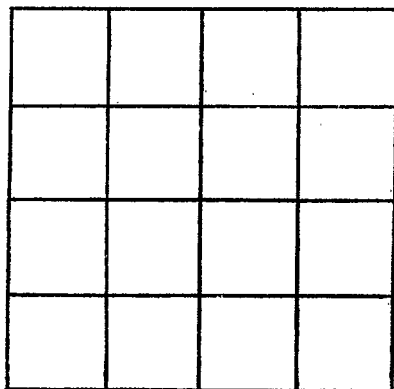

SECTION _____

Please indicate well location X.

ADDITIONAL INFORMATION

If more than one screen, show locations of each on sketch.