

MARION
G-50
01-25-80

MISSISSIPPI
BOARD OF WATER COMMISSIONERS
416 North State Street
Jackson, Mississippi 39201

CODED

WATER WELL DRILLERS LOG

1-25-80 Griner Drilling Marion

date well completed

firm name

county well located

LANDOWNER:

Hunt Petroleum
P.O. Box 4096
Houma, La 70361
(mailing address)

description of formations encountered

from

to

Sand, pea gravel	0	168
chalk	168	210
sand	210	294
chalk	294	399
sand CODED	399	515
chalk	515	546
sand	546	693
chalk	693	703

WELL LOCATION: 1500' N + 1500' W
Sec. 24 T. 4 N. R. 18 E. OF Morris

1/2 mile S of Improve (distance) (direction) (nearest town)

WELL PURPOSE: oil field supply (home, irrigation, municipal, industrial)

WELL COMPLETION DATA:

- (1) diameter (inches) 3"
- (2) total depth (feet) 703'
- (3) static water level (feet) 200' ^{below} _{above} top of ground.
- (4) casing steel, 693' (material) (depth)
3" (size) If telescope see back.
- (5) screen 42' 651' (length) (depth to top)
3" perforated (size) (material)
- (6) pump - 80 (HP) (yield gpm)
AC (type power)
- (7) electric log - (yes or no)

(organization running log)

(8) how well bottom plugged Or ange peel

DRILLERS REMARKS:


DEPT. OF NATURAL RESOURCES
BUREAU OF LAND & WATER RESOURCES

FEB 28 1980

RECEIVED

If well telescopes please sketch and show depths.

GROUND LEVEL

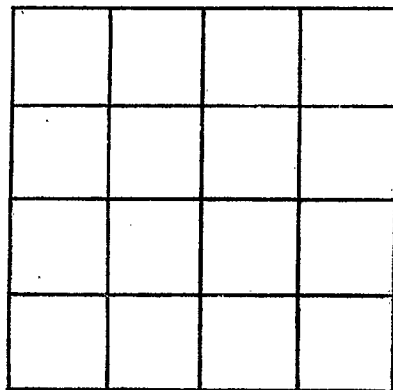

SECTION _____

Please indicate well location X.

ADDITIONAL INFORMATION

If more than one screen,
show locations of each on sketch.