

MARION

G-51
7-2-80

MISSISSIPPI  
BOARD OF WATER COMMISSIONERS  
416 North State Street  
Jackson, Mississippi 39201

CODED

WATER WELL DRILLERS LOG

7-2-80 *Griner Drilling Service, Inc* *Marion*  
date well completed firm name county well located

LANDOWNER:  
*Champion Petroleum*  
*East Texas District Office*  
*1203 N.W. Loop 281*  
*Longview, Texas 75605*  
(mailing address)

description of formations encountered	from	to
<i>gravel</i>	<i>0</i>	<i>21</i>
<i>clay</i>	<i>21</i>	<i>105</i>
<i>clay and sand</i>	<i>105</i>	<i>168</i>
<i>gravel</i>	<i>168</i>	<i>336</i>

WELL LOCATION: *1500' N + 1500' E*  
*sec. 5 T. 4 N. R. 18 E of*  
*cedar Grove*  
(distance) (direction) (nearest town)

*No. 2*  
*H. J. Fosterberg*

WELL PURPOSE: *oil field supply*  
(home, irrigation, municipal, industrial)

WELL COMPLETION DATA:

- (1) diameter (inches) *4"*
- (2) total depth (feet) *336'*
- (3) static water level (feet) *70'* below above  
top of ground.
- (4) casing *steel* *336'*  
(material) (depth)  
*4"*  
(size) if telescope see back.
- (5) screen *42'* *294'*  
(length) (depth to top)  
*4" perforated*  
(size) (material)
- (6) pump *AC* *75*  
(HP) (yield gpm)  
*AC*  
(type power)
- (7) electric log \_\_\_\_\_  
(yes or no)  
(organization running log)

CODED

(8) how well bottom plugged *orange*  
*peel*


DRILLERS REMARKS:

DEPT. OF NATURAL RESOURCES  
BUREAU OF LAND & WATER RESOURCES

JUL 14 1980  
RECEIVED

If well telescopes please  
sketch and show depths.

GROUND LEVEL

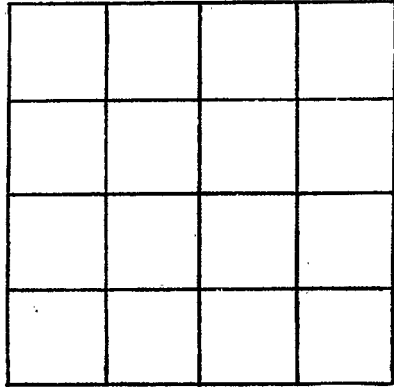

SECTION \_\_\_\_\_

Please indicate well location X.

ADDITIONAL INFORMATION

If more than one screen,  
show locations of each on sketch.