

MARION

G-52

8/3/80

8-3-80

MISSISSIPPI BOARD OF WATER COMMISSIONERS
416 North State Street
Jackson, Mississippi 39201

CODED

WATER WELL DRILLERS LOG

Garner Drilling Service, Inc.

Marion

date well completed

firm name

county well located

LANDOWNER:

*First Energy Corp.
P.O. Box 2066
Jackson, Mo 39205*
(mailing address)

description of formations encountered

from

to

*sand + pea gravel
clay*

*0 105
105 147*

WELL LOCATION: 1500' N + 1500' E

*No 1
J.C. ...
et al 8-11*
T 4 N R 18 E of *Cedar Grove*
(distance) (direction) (nearest town)

sand + gravel

147 357

WELL PURPOSE: *oil field supply*
(home, irrigation, municipal, industrial)

CODED

WELL COMPLETION DATA:

- (1) diameter (inches) 4"
- (2) total depth (feet) 357'
- (3) static water level (feet) 75' ^{below} above top of ground.
- (4) casing steel, 336'
(material) (depth)
4"
(size) if telescope see back.
- (5) screen 42', 294'
(length) (depth to top)
4", perforated
(size) (material)
- (6) pump 80
(HP) (yield gpm)
ac
(type power)
- (7) electric log —
(yes or no)
(organization running log)

(8) how well bottom plugged *orange peel*

DRILLERS REMARKS:


DEPT. OF NATURAL RESOURCES
BUREAU OF LAND & WATER RESOURCES

AUG 27 1980

RECEIVED

If well telescopes please
sketch and show depths.

GROUND LEVEL

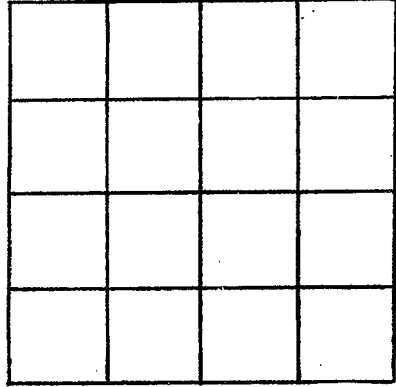

SECTION _____

Please indicate well location X.

ADDITIONAL INFORMATION

If more than one screen,
show locations of each on sketch.