

MISSISSIPPI DEPARTMENT OF NATURAL RESOURCES

Bureau of Land and Water Resources

Southport Mall

P.O. Box 10631

Jackson, Mississippi 39209

WATER WELL DRILLERS LOG

CODED

MARION
G 53
3-24-81

Griner Drilling Service, Inc.

Marion

date well completed

firm name

county well located

LANDOWNER:

Systems Fuel, Inc.
P.O. Drawer 728
Prentiss, MS 39349
(mailing address)

description of formations encountered

from to

clay, chalk 0 84

sand, gravel 84 210

chalk 210 294

streaked 294 336

sand, pea gravel 336 420

streaked chalk 420 462

WELL LOCATION: 1500' N of 1500w

sec. 27 T. 40N R. 18E of

Columbia Training School miles _____ of _____ (nearest town)

WELL PURPOSE: oil field supply
(home, irrigation, municipal, industrial)

WELL COMPLETION DATA:

(1) diameter (inches) 3"

(2) total depth (feet) 462'

(3) static water level (feet) 100' below
top of ground.

(4) casing steel, 420'
(material), (depth)

3"
(size) if telescope see back.

(5) screen 42', 378'
(length), (depth to top)

3", perforated
(size), (material)

(6) pump —, 75
(HP), (yield gpm)

AC
(type power)

(7) electric log —
(yes or no)

(organization running log)

(8) how well bottom plugged Orange

peel

DRILLERS REMARKS:


DEPT. OF NATURAL RESOURCES
BUREAU OF LAND & WATER RESOURCES

MAR 31 1981

RECEIVED

If well telescopes please sketch and show depths.

GROUND LEVEL

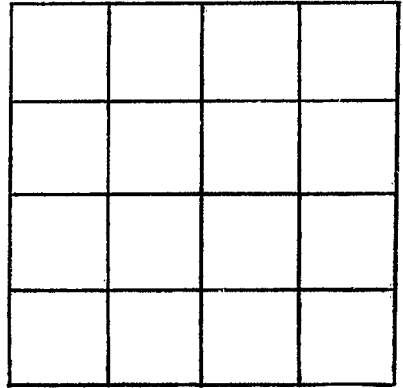

SECTION _____

Please indicate well location X.

ADDITIONAL INFORMATION

If more than one screen, show locations of each on sketch.