

MISSISSIPPI DEPARTMENT OF NATURAL RESOURCES

Bureau of Land and Water Resources

Southport Mall

P.O. Box 10631

Jackson, Mississippi 39209

WATER WELL DRILLERS LOG

TOM GRIFFITH

CODED

84 PLUMBING & WELL SERVICE, INC.

Marion

4-27 date well completed

320 MARION AVE.

county well located

COLUMBIA, MS 39429

LANDOWNER: Rome Bonner

description of formations encountered

from

to

Rt. 7 Box 348

Clay-Gravel

1'

10'

Columbia, MS 39429

Pea Gravel

10'

30'

(mailing address)

WELL LOCATION:

sec. 32 T. 4 N. R. 18 E. S. 5 miles East of Expose

WELL PURPOSE: Home (home, irrigation, municipal, industrial)

WELL COMPLETION DATA:

- (1) diameter (inches) 2"
(2) total depth (feet) 30'
(3) static water level (feet) 18' below top of ground.
(4) casing PVC, 25' (material), (depth)
(5) screen 5' length, 25' depth to top, 2" #20 PVC (size), (material)
(6) pump 1 1/2 HP, 10 yield gpm, Elec. (type power)
(7) electric log N/A (yes or/no)
(8) how well bottom plugged BWV

DEPT. OF NATURAL RESOURCES BUREAU OF LAND & WATER RESOURCES

MAY 9 1984


RECEIVED

DRILLERS REMARKS:

good well @ 30' tried 200 (fine sand & 3gpm)

If well telescopes please sketch and show depths.

GROUND LEVEL

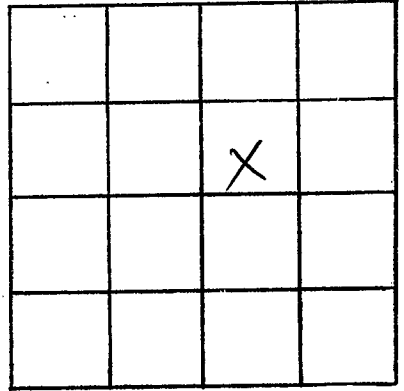

SECTION 5

Please indicate well location X.

ADDITIONAL INFORMATION

If more than one screen,
show locations of each on sketch.