

MISSISSIPPI DEPARTMENT OF NATURAL RESOURCES

Bureau of Land and Water Resources

Southport Mall

CODED

P.O. Box 10631

Jackson, Mississippi 39209

WATER WELL DRILLERS LOG

Griner Drilling Service, Inc.

Marion

G-57
MARION Co.
3-7-85

3-7-85
date well completed

Griner Drilling Service, Inc.
firm name

Marion
county well located

LANDOWNER:	description of formations encountered	from	to
(mailing address)			
<i>Delta Drilling</i> <i>P.O. Box 52789 OCS</i> <i>Lafayette, La. 70505</i>	<i>streaked sand & gravel</i>	<i>0</i>	<i>168</i>
WELL LOCATION: <i>180' S + 1500' E</i> <i>29 T 4 N R 14 E of</i> <i>Jack sec. 29 T 4 N R 14 E of</i> <i>E. 1/4 S. Morganbown Field</i> <i>NO. 1 (direction) of (nearest town)</i> <i>Federal 00</i> <i>Lumb.</i>	<i>CLAY</i>	<i>168</i>	<i>420</i>
WELL PURPOSE: <i>oilfield supply</i> (home, irrigation, municipal, industrial)	<i>streaked sand</i>	<i>420</i>	<i>441</i>
WELL COMPLETION DATA:	<i>course sand, pea gravel</i>	<i>441</i>	<i>588</i>
(1) diameter (inches) <i>3"</i>	<i>streaked mostly SAND</i>	<i>588</i>	<i>609</i>
(2) total depth (feet) <i>609'</i>			
(3) static water level (feet) <i>130' below</i> top of ground.			
(4) casing <i>steel 588'</i> (material) (depth)			
<i>3"</i> (size) if telescope see back.			
(5) screen <i>42' 546'</i> (length) (depth to top)			
<i>3" perforated</i> (size) (material)			
(6) pump <i>- 65-70</i> (HP) (yield gpm)			
<i>AC</i> (type power)			
(7) electric log <i>(yes or no)</i>			
(organization running log)			
(8) how well bottom plugged <i>orange peel</i>			

RECEIVED


MAR 1 2 1985

Department of Natural Resources
Bureau of Land & Water Resources

DRILLERS REMARKS:

If well telescopes please sketch and show depths.

GROUND LEVEL

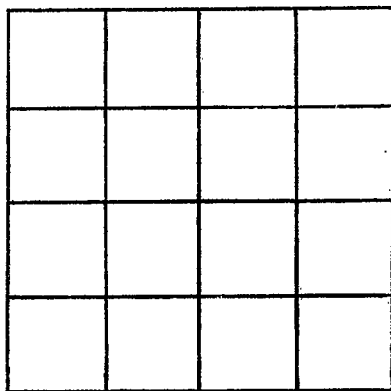

SECTION _____

Please indicate well location X.

ADDITIONAL INFORMATION

If more than one screen, show locations of each on sketch.