

MARION
058
5-10-85

MISSISSIPPI DEPARTMENT OF NATURAL RESOURCES
 Bureau of Land and Water Resources
 Southport Mall
 P.O. Box 10631
 Jackson, Mississippi 39209
WATER WELL DRILLERS LOG

5-10 1985 *Fitzgibbon Well Serv* *marion*
 date well completed firm name county well located

LANDOWNER:
Bill Clark
R.R. Columbia, ms.
 (mailing address)

description of formations encountered	from	to
<i>Red Clay</i>	<i>0</i>	<i>20</i>
<i>Red sand</i>	<i>20</i>	<i>90</i>
<i>Coarse sand & gravel</i>	<i>90</i>	<i>105</i>

WELL LOCATION: *18*
 sec. *14* T. *4* N. R. *4E*
1 miles *NE* of *Columbia*
 (distance) (direction) (nearest town)

WELL PURPOSE:
 (home, irrigation, municipal, industrial)

WELL COMPLETION DATA:

(1) diameter (inches) *4*

(2) total depth (feet) *105*

(3) static water level (feet) *40* below above top of ground.

(4) casing *PVC*, *95*
 (material) (depth)
4 If telescope see back.
 (size)

(5) screen *10*, *95*
 (length) (depth to top)
4, *PVC*
 (size) (material)

(6) pump *1/2*, *10*
 (HP) (yield gpm)
Clu
 (type power)

(7) electric log *no*
 (yes or no)
 (organization running log)

(8) how well bottom plugged *Sealed off*


RECEIVED
 MAY 17 1985

DRILLERS REMARKS:

Department of Natural Resources
 Bureau of Land & Water Resources

If well telescopes please sketch and show depths.

GROUND LEVEL

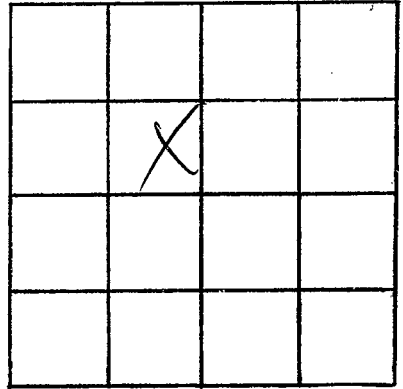

SECTION 14

Please indicate well location X.

ADDITIONAL INFORMATION

If more than one screen, show locations of each on sketch.