

MISSISSIPPI DEPARTMENT OF ENVIRONMENTAL QUALITY
Bureau of Land and Water Resources

P. O. Box 10631
Jackson, MS 39289-0631
WATER WELL DRILLERS LOG

COUNTY WELL LOCATED Marion		
WELL NUMBER G60	CODED <input checked="" type="checkbox"/>	PERMIT NUMBER
DATE WELL COMPLETED 8/26/96		NAME OF DRILLING FIRM Griner Drilling Service, Inc.

NAME & MAILING ADDRESS OF LANDOWNER City of Columbia		
City Hall		
Columbia, Ms 39429		
WELL LOCATION: SWSWSW	SEC 34	TOWNSHIP 4
		RANGE 18
		N
		S
		E
		W
DISTANCE 0 Miles	DIRECTION N	NEAREST TOWN Columbia
OTHER LANDMARK By National Guard on Hwy. 44		
WELL PURPOSE: Home, Irrigation, Municipal, Industrial, Fish Pond, etc. Municipal		

PUMP DATA		
PUMP TYPE (Circle One): Submersible, Turbine, Jet, Flowing Well, Other (Describe) _____		
POWER TYPE (Circle One): Electric, Tractor, Diesel, Gasoline, Butane, Other (Describe) _____ H/P _____		
Pump Capacity (GPM)	No. of Stages	Setting Depth _____ FT.
PUMP TEST		
Well yielded _____ GPM with a drawdown of _____ ft. after _____ hours of pumping		


WELL DATA		
Well Depth	Casing Diameter (In.)	Casing Length (Ft.)
Type of Casing	Hole Depth 521	Depth to Static Water Level
TYPE OF COMPLETION: (Circle One or More): Gravel Packed, Underreamed, Telescoped, Natural Development, Open Hole, Other (Describe) _____		
Top of Lap Pipe or Reduction in Casing		
FEET		
IF TELESCOPED OR MORE THAN ONE SCREEN: USE BACK PAGE		

LOG DATA	
TYPE OF LOG RUN (Circle One): Electric, Gamma Ray Density, Sonic, Neutron, Other (Describe) _____	
Name of Organization Running Log Griner Drilling Service, Inc.	

SCREEN DATA		
Diameter - Inches	Length - Feet	Slot Size - Inches
Screen Type	Depth to Bottom - Feet	

GEOLOGIC DATA (Office Use Only)			
Surface Elev.	Geologic Unit	Unit Thickness	Depth to Top
Subs. SWL	Date	Analysis	Aquifer Test
Driller's Remarks No permanent well was made. Abandonment attached.			

DESCRIPTION OF FORMATIONS ENCOUNTERED	FROM	TO
Gravel	0	16
Clay	16	48
Sand	48	173
Clay	173	265
Sand	265	521

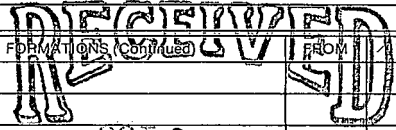

OCT 31 1996

Dept. of Environmental Quality
Office of Land & Water Resources

FORMATIONS (Continued)	FROM	TO

IF MORE SPACE IS NEEDED, USE BACK

If well telescopes please
sketch and show depths.

GROUND LEVEL

SECTION _____

Please indicate well location X.

ADDITIONAL INFORMATION

If more than one screen,
show location of each on sketch.