
State W	ell Report					
	Part 1	For Office Use Only:				
Mississippi Departmen	t of Environmental Quality	Aquifer:				
	and Water Resources	Well #: <u>G-79</u>				
	30x 10631 1S 39289-0631					
	961-5210	L. S. Elevation:				
	4-6938 (fax)	E-log #:				
State Law requires that this report be prepared by the driller in detail and filed with the Department within						
30 days of completion of drilling of the well. Well Owner Information	Wel	Location				
Owner Name JEREMY MICIEIIO		-" Longitude: <u>81•48</u> , <u>35</u> ."				
Mailing Address: 127 OID SUMRALL ROAD	Method of Lat/Long (circle or	ne): Conventional Survey,				
······································	USGS quad, Hand-held	GPS, Survey-grade GPS				
<u>COlumBia M5. 39429</u> City State Zip Code	SE 14 NE 14 Sec 33					
	Distance Direction	Nearest Town				
Telephone No. (601) 441 - 6284	Miles <u><i>N. E.</i></u>	of Columbia				
Well 1	Data					
Purpose of Well (circle one) Home Industrial Public Supply	Irrigation Fish Culture	Other:				
Date well drilling started: 7-12-05 Date	well drilling completed:	12-05				
If flowing, method of flow regulation: Valve Other (describe)						
Static Water Level: <u>6.3'</u> feet above or below (circle one)	and surface Date measured:	7-12-05				
Method of Measurement (circle one) steel tape electric tape air line other:						
Hole depth: <u>162'</u> Well depth: <u>160'</u>	Well grouted to a depth of _	feet				
Type of grout (circle one): Cement Bentonite Mix						
Casing length: <u>20</u> feet Casing diameter: <u>4"</u> inches Type of casing: <u>P.V.C.</u>						
Screen length: <u>Qo'</u> feet Screen diameter: <u>H'</u> inches Type of screen: <u>P.V.C. SLOTED</u>						
Screen slot size: <u>• 008</u> inches Setting depth: From <u>140</u> feet to <u>160'</u> feet						
Type of completion (circle all applicable): Gravel packed Underreamed Telescoped Open noie Natural Development						
Other (describe):						
Top of lap pipe or reduction in casing:feet. If telescoped or more than one screen, describe on back of page						
Logs run (circle all applicable): (No log run) Electric Gamma Ray Density Sonic Neutron Other:						
Name of organization running log(s):						
I certify that the well was drilled, constructed, and completed in accordance with all applicable requirements of the Mississippi						
Department of Environmental Quality and/or the Mississippi Department of Health regulations and state laws.						
STUCKEY'S WEN SERVICE INC 0-68	36 Jackie	Stuckey				
Print Name of Water Well Contractor and License No.		Water Well Contractor				
RECEIVED						
JUL 2 2 2005						
		BY: OLWF				


If well telescopes please sketch below and show depths.

Ground Level

		•	
	Description of Formations Encountered	From_	To
— ſ	C L A-N	11'	12'
ſ	SAND + PEA DRAVEL CLAY CLAY + SAND-(STREKED) SAND + PEA BAAVEL	13'	25'
[CLAY	29'	20'
[CLAY + SAND-(STREKED)	71'	120'
ļ	SAND + PEA DRAVEL	121'	160'
	CLAY	160	162
ļ		ļ	
Ļ			┠
ļ			
ŀ		- <u> </u>	
ł			
ŀ			
ł		+	
ł			
		1	
}		1	
1	· · · · · · · · · · · · · · · · · · ·		
		1	
1			
•			

G-79

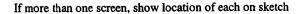

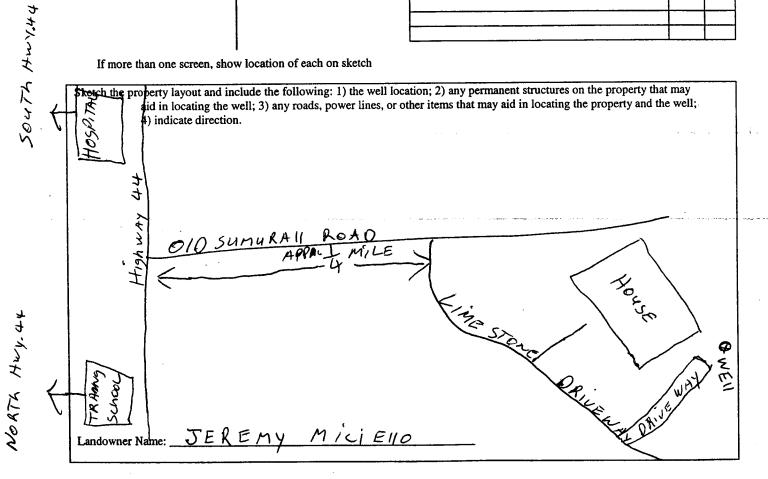

actor

Signature of Water Well Contractor

RECEIVED JUL 2 2 2005 BY: OLWR

STATE WELL REPORT						
County: <u>MARION</u> Permit #: Driller: <u>JAC KIE STUCKEY</u> Date completed: <u>7-13-05</u>	Part 2 Pump Installer's Completion Report Mississippi Department of Environmental Quality Office of Land and Water Resources P.O. Box 10631 Jackson, MS 39289-0631 (601)961-5210 (601)354-6938 (fax)		ty Aquifer: Well #: Elevation:	1ce Use Only: 		
This report should be prepared by the installation of pump.		and filed with the Depa		's of the		
Well Owner Informati		Well Location				
Owner Name: JEREMY Mic	TEILO	Latitude:	Longitude:			
Mailing Address: 127 010 54ml <u>Colum Bia, 115.</u> City State		Method of Lat/Long (circle one): Conventional Survey, USGS quad, Hand-held GPS, Survey-grade GPS		vey-grade GPS		
-	·	Distance Direction Nearest Town				
Telephone No. (601) 441-628	<u> </u>		<u>z. of Colum</u>	<u>DjA</u>		
Pump Type Circle one			Power Type Circle one			
Air Lift Jet	Submersible	Diesel Engine	Gasoline Engine	Natural Gas		
Bucket Piston	Turbine	Electric Motor	Hand	Tractor PTO		
Centrifugal Rotary	Flowing Well	Windmill	Other (specify):			
Other (specify):		Horse Power Rating of	Motor:/			
Date Pump Installed: 7-13-05		Setting Depth:	10	_feet		
Rated Pump Capacity: 9	Gallons Per Minute	Number of Stages:				
Pump Test Data		Method	of Measuring Water Circle one	Level		
Date Well Tested: 7-13-05 Static Water Level (A): 63' Feet Pumping Water Level (B): Feet H	Below Land Surface	Air Line Electr Other (specify):	ic Measuring Line	Steel Tape		
Drawdown [(B) – (A)]:Feet	Below Land Surface	For flowing well, meas	ured shut in head:	feet		
Test Pumping Rate:		Well yieldedGPM with a drawdown of				
Duration of Pump Test (minimum 4 hours):	hours	feet	afterh	ours of pumping		
I HEREBY CERTIFY that the above statem <u>JACKIE STUCKEY - 0-68</u> Print Name of Pump Installer and License N		f my knowledge.		RECEIVE		

•

-

•

.

.

JUL 2 2 2005 BY: OLWR