

Marion  
 G 2000  
 6-75

MISSISSIPPI  
 BOARD OF WATER COMMISSIONERS  
 416 North State Street  
 Jackson, Mississippi 39201

WATER WELL DRILLERS LOG

June 1975 E.B. Sherrard Marion  
 date well completed firm name county well located


LANDOWNER:	description of formations encountered	from	to
Mary Hill	GRAVEL SANDY		
Columbia, Ms.	CLAY	0	10'
(mailing/address)	STR. GR. & SAND	10	70'
	SAND & GRAVEL	70	94'
<b>WELL LOCATION:</b>			
sec 20 T 4 N R 18 E 13 V			
2 miles N Columbia			
(distance) (direction) (nearest town)			
<b>WELL PURPOSE:</b>			
(home) irrigation, municipal, industrial			
<b>WELL COMPLETION DATA:</b>			
(1) diameter (inches) 2"			
(2) total depth (feet) 94'			
(3) static water level (feet) 50' below above top of ground.			
(4) casing (material) (depth) pl. 89'			
2" (size) if telescope see back.			
(5) screen (length) (depth to top) 5'			
2" (size) pl (material)			
(6) pump (HP) (yield gpm) 1 7			
(type power) E			
(7) electric log (yes or no) (no)			
(organization running log)			
(8) how well bottom plugged BWV			
<b>DRILLERS REMARKS:</b>			

RECEIVED  
 DEC - 5 1975

MISS. BU. OF WATER COMM

If well telescopes please sketch and show depths.

GROUND LEVEL

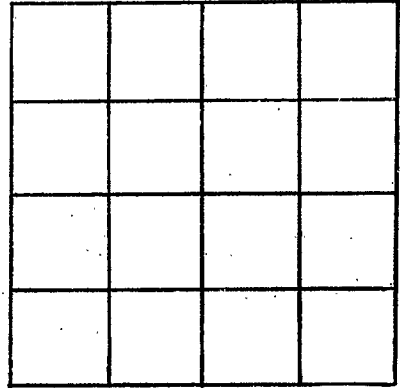

SECTION \_\_\_\_\_

Please indicate well location X.

ADDITIONAL INFORMATION

If more than one screen, show locations of each on sketch.