

Marion  
G 2003  
3/15/76

MISSISSIPPI  
BOARD OF WATER COMMISSIONERS  
416 North State Street  
Jackson, Mississippi 39201

WATER WELL DRILLERS LOG

GRINER - GINN

Marion

3-15 1976  
date well completed

firm name

county well located


LANDOWNER:	description of formations encountered	from	to
Bo McDowell			
Rt. 4 Columbia, Miss (mailing address)	Top Soil	0	1
	Clay	1	16
	Clay & Gravel	16	30
	Gravel, Small	30	48
	Sand	48	80
WELL LOCATION:			
sec 26 T 4 N R 18 E 3 miles NE of Columbia (distance) (direction) (nearest town)			
WELL PURPOSE: HOME (home, irrigation, municipal, industrial)			
WELL COMPLETION DATA:			
(1) diameter (inches) 2"			
(2) total depth (feet) 80			
(3) static water level (feet) 50 below top of ground.			
(4) casing PVC 70 (material) (depth) 2" if telescope see back. (size)			
(5) screen 10' 70 (length) (depth to top) 2" PVC (size) (material)			
(6) pump 1/2 HP Pump (type power) (yield gpm)			
(7) electric log NO (yes or no)			
(organization running log)			
(8) how well bottom plugged B.W. Valve			
DRILLERS REMARKS: Furnished own pump			

RECEIVED  
OCT 22 1976

MISS. BD. OF WATER COMMISSIONERS

If well telescopes please sketch and show depths.

GROUND LEVEL

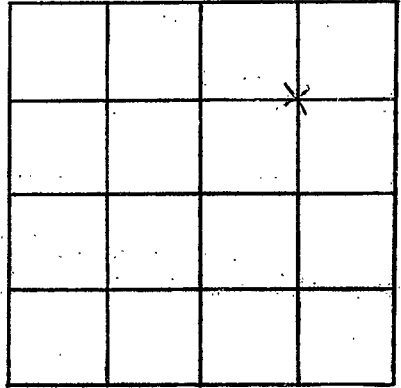

SECTION 26

Please indicate well location X.

ADDITIONAL INFORMATION

If more than one screen, show locations of each on sketch.