

Marion  
 G 2006  
 4/ 76

MISSISSIPPI  
 BOARD OF WATER COMMISSIONERS  
 416 North State Street  
 Jackson, Mississippi 39201

WATER WELL DRILLERS LOG


April 1976 E.B. Sherrard Marion  
 date well completed firm name county well located

LANDOWNER:	description of formations encountered	from	to
Benny Barber Columbia, MS. (mailing address)	SAND & CLAY STREAKS SAND & PEA GR.	0 80	80' 125'
<b>WELL LOCATION:</b> sec 33 T 40 N R 7 E S 1 miles E of Columbia (distance) (direction) (nearest town)			
<b>WELL PURPOSE:</b> (home, irrigation, municipal, industrial)			
<b>WELL COMPLETION DATA:</b>			
(1) diameter (inches) 2"			
(2) total depth (feet) 125'			
(3) static water level (feet) 50' below above top of ground.			
(4) casing pl. 120' (material) (depth)			
2" If telescope see back. (size)			
(5) screen 5' (length) (depth to top)			
2" pl. (size) (material)			
(6) pump 1 (HP) 8 (yield gpm)			
elec. (type power)			
(7) electric log (yes or no)			
(organization running log)			
(8) how well bottom plugged B.W.V.			
<b>DRILLERS REMARKS:</b>			

RECEIVED  
 OCT 18 1976

If well telescopes please  
sketch and show depths.

GROUND LEVEL

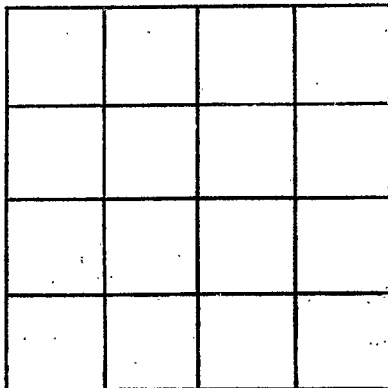

SECTION \_\_\_\_\_

Please indicate well location X.

ADDITIONAL INFORMATION

If more than one screen,  
show locations of each on sketch.