

Marion
 B 2007
 12/20/77

MISSISSIPPI
 BOARD OF WATER COMMISSIONERS
 416 North State Street
 Jackson, Mississippi 39201

WATER WELL DRILLERS LOG

Dec 20 19 77 *Dunn Plumbing Well Marion*
 d. well completed firm name county well located

LANDOWNER:
Mr. Mike Cupit
Columbia, Miss.
 (mailing address)

description of formations encountered	from	to
	<i>Top Soil</i>	<i>0</i>
<i>Clay</i>	<i>1</i>	<i>14</i>
<i>Chalk</i>	<i>1</i>	<i>82</i>
<i>SAND</i>	<i>82</i>	<i>125</i>

WELL LOCATION:
 sec *20* T *4* N R *18* E
1 miles *NE* of *Columbia*
 (distance) (direction) (nearest town)

WELL PURPOSE: *HOME*
 (home, irrigation, municipal, industrial)

WELL COMPLETION DATA:
 (1) diameter (inches) *4"*
 (2) total depth (feet) *125 ft.*
 (3) static water level (feet) ~~75~~ *60* below above top of ground.
 (4) casing *Plastic*, *105*,
 (material) (depth)
4" if telescope see back.
 (size)
 (5) screen *20 ft.*, *105*
 (length) (depth to top)
4", *Plastic*
 (size) (material)
 (6) pump *3/4*
 (HP) (yield gpm)
Elew
 (type power)
 (7) electric log *no*
 (yes or no)
 (organization running log)


(8) how well bottom plugged
B.W. Valve

DRILLERS REMARKS:

RECEIVED
 MAR - 2 1978
 MISS. BD OF WATER COMMISSIONERS

If well telescopes please sketch and show depths.

GROUND LEVEL

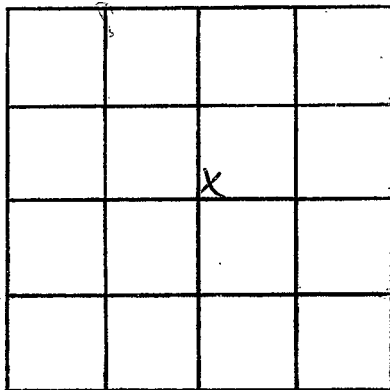

SECTION 20

Please indicate well location X.

ADDITIONAL INFORMATION

If more than one screen, show locations of each on sketch.