

MARION
 E 2009
 1/25/78

MISSISSIPPI
 BOARD OF WATER COMMISSIONERS
 416 North State Street
 Jackson, Mississippi 39201

WATER WELL DRILLERS LOG

1/25 date well completed 19 78 Hollingsen Well firm name MARION county well located

LANDOWNER: Tommy Green
Rt 4 Box 305
Columbia MS
 (mailing address)

description of formations encountered	from	to
chalk	0	10
sand, gravel	10	40

WELL LOCATION:
 sec 18 T 4 (N) S R 18 (E) W
1 miles N of Columbia
 (distance) (direction) (nearest town)

WELL PURPOSE: Home
 (home, irrigation, municipal, industrial)

- WELL COMPLETION DATA:
- (1) diameter (inches) 2"
 - (2) total depth (feet) 40
 - (3) static water level (feet) 20 (below above top of ground)
 - (4) casing pvc, 35
 (material) (depth)
 (size) if telescope see back.
 - (5) screen 5, 35
 (length) (depth to top)
2, pvc
 (size) (material)
 - (6) pump 1/2, 6
 (HP) (yield gpm)
elect
 (type power)
 - (7) electric log _____
 (yes or no)

(organization running log)
 (8) how well bottom plugged sand
shale


DRILLERS REMARKS: good well

RECEIVED
 FEB 10 1978

MISS. BD. OF WATER COMMISSIONERS

If well telescopes please sketch and show depths.

GROUND LEVEL

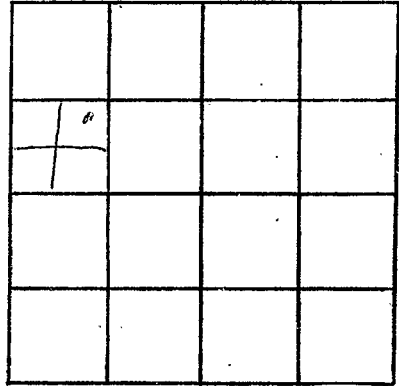

SECTION 18

Please indicate well location X.

ADDITIONAL INFORMATION

A series of horizontal lines for writing additional information.

If more than one screen, show locations of each on sketch.