

Marion

G 2010

5-29-79

MISSISSIPPI
 BOARD OF WATER COMMISSIONERS
 416 North State Street
 Jackson, Mississippi 39201

WATER WELL DRILLERS LOG

May 29 1979
date well completed

TOM GRIFFITH
PLUMBING & WELL SERVICE, INC.
well name

Marion
county well located

LANDOWNER:
 Mr. Ray Daniels
 Rt. 1 Columbia
 (mailing address)

description of formations encountered	from	to
Top soil	0	1
Clay	1	27
Sand	27	60
Gravel	60	85
Chalk	85	90
Sand	90	125

WELL LOCATION:
 sec. 7 T 4 N R 18 E
 S W
 3 miles N of Columbia
 (distance) (direction) (nearest town)

WELL PURPOSE: Home
 (home, irrigation, municipal, industrial)

WELL COMPLETION DATA:

(1) diameter (inches) 2" ft.

(2) total depth (feet) 185 ft.

(3) static water level (feet) 60 ft. Below/above top of ground.

(4) casing plaster 165 ft.
 (material) (depth)

2"
 (size) if telescope see back.

(5) screen 20 ft. 165 ft.
 (length) (depth to top)

2" plaster
 (size) (material)

(6) pump 1 HP
 (HP) (yield gpm)

Electric
 (type power)

(7) electric log no.
 (yes or no)

(organization running log)

(8) how well bottom plugged
Back Wash Valve

DRILLERS REMARKS:


Miss. Board of Water Comm.

JUL 5 1979

RECEIVED

If well telescopes please sketch and show depths.

GROUND LEVEL

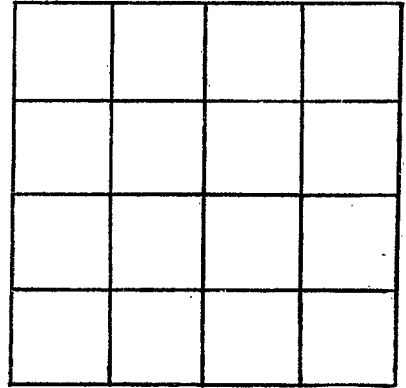

SECTION _____

Please indicate well location X.

ADDITIONAL INFORMATION

If more than one screen, show locations of each on sketch.