

MARION
 G 2011
 12-29-78

MISSISSIPPI
 BOARD OF WATER COMMISSIONERS
 416 North State Street
 Jackson, Mississippi 39201

WATER WELL DRILLERS LOG
 TOM GRIFFITH
 PLUMBING & WELL SERVICE, INC.

Nov. 29 1979 date well completed
 firm name
 county well located Marion

LANDOWNER:

Mr. Norman Spira
Pt. 3, Box 14-Columbia
 (mailing address) Mrs.

description of formations encountered

description of formations encountered	from	to
<u>Topsoil</u>	<u>0</u>	<u>1</u>
<u>Clay</u>	<u>1</u>	<u>4</u>
<u>Sand</u>	<u>4</u>	<u>14</u>
<u>Light gravel</u>	<u>14</u>	<u>31</u>
<u>Chalk</u>	<u>31</u>	<u>80</u>
<u>Sand</u>	<u>80</u>	<u>125</u>

WELL LOCATION:

sec. 38 T. 4 N R. 18 E
1/2 miles N of Columbia
 (distance) (direction) (nearest town)

WELL PURPOSE:

Home
 (home, irrigation, municipal, industrial)

WELL COMPLETION DATA:

- (1) diameter (inches) 2 ft
- (2) total depth (feet) 125 ft
- (3) static water level (feet) 60 ft below top of ground.
- (4) casing plastic 1 1/2 ft
 (material) (depth)
2 ft (size) if telescope see back.
- (5) screen 10 ft, 1 1/2 ft
 (length) (depth to top)
2 ft, plastic
 (size) (material)
- (6) pump 1 H.P. 7
 (HP) (yield/gpm)
Electric
 (type power)
- (7) electric log no
 (yes or no)

(organization running log)

(8) how well bottom plugged Back Wash Valve

DRILLERS REMARKS:


Miss. Board of Water Comm.

FEB 29 1979

RECEIVED

If well telescopes please sketch and show depths.

GROUND LEVEL

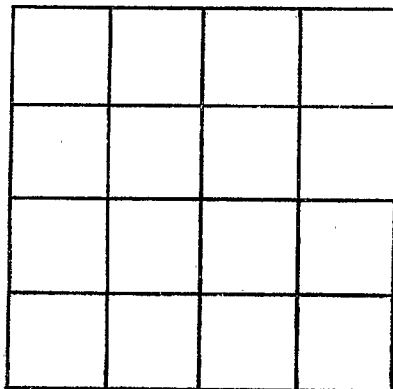

SECTION _____

Please indicate well location X.

ADDITIONAL INFORMATION

If more than one screen,
show locations of each on sketch.