

MARION
 G 2012
 02-20-79

MISSISSIPPI
 BOARD OF WATER COMMISSIONERS
 416 North State Street
 Jackson, Mississippi 39201

WATER WELL DRILLERS LOG

Feb. 20 1979 Tom Griffith Marion
 date well completed first name county well located

LANDOWNER:
 Mrs. Jerrine Bridges
 Rt. 4 - Columbia Miss.
 (mailing address)

description of formations encountered	from	to
Top Soil	0	2
Clay	2	19
Sand	18	47
Clay	47	98
Sand & Gravel	98	170
Sand	170	205

WELL LOCATION:
 sec. 7 T 4 N R 18 E
 S W
 5 miles N of Columbia
 (distance) (direction) (nearest town)

WELL PURPOSE:
 (home, irrigation, municipal, industrial)

WELL COMPLETION DATA:

(1) diameter (inches) 2"

(2) total depth (feet) 205 ft.

(3) static water level (feet) 80 ft. below top of ground.

(4) casing plastic, 185 ft.
 (material) (depth)

2" if telescope see back.
 (size)

(5) screen 20 ft., 185 ft.
 (length) (depth to top)

2" plastic
 (size) (material)

(6) pump 1 HP 10
 (HP) (yield gpm)

Electric
 (type power)

(7) electric log No.
 (yes or no)

(organization running log)

(8) how well bottom plugged Back Wash Valve

Misc. Board of Water Comm.


MAY -4 1979

RECEIVED

DRILLERS REMARKS:

If well telescopes please sketch and show depths.

GROUND LEVEL

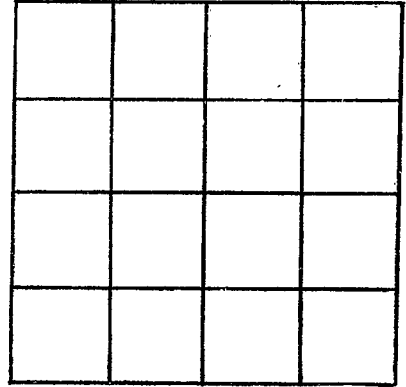

SECTION _____

Please indicate well location X.

ADDITIONAL INFORMATION

If more than one screen,
show locations of each on sketch.