

Marion
G
2013
8-20-79
8/70

MISSISSIPPI
 BOARD OF WATER COMMISSIONERS
 416 North State Street
 Jackson, Mississippi 39201

WATER WELL DRILLERS LOG

79 **TOM GRIFFITH**
 PLUMBING & WELL SERVICE, INC.

Marion
 county well located

LANDOWNER:

M. Joseph Paddy
Church St - Columbia
 (mailing address) Miss

description of formations encountered

from to

Topsoil
Clay
Sand
Gravel
Chert
Limestone
 0 1
 1 16
 16 31
 31 47
 47 91
 91 150

WELL LOCATION:

sec. 36 T. 4 N. R. 18 E.
H miles E of Phlox
 (distance) (direction) (nearest town)

WELL PURPOSE:

(home) Irrigation, municipal, industrial

WELL COMPLETION DATA:

- (1) diameter (inches) 2"
- (2) total depth (feet) 150 ft.
- (3) static water level (feet) 115 ft. below top of ground.
- (4) casing Plastic 130 ft
 (material) (depth)
2" if telescope see back.
 (size)
- (5) screen 20 ft 130 ft
 (length) (depth to top)
2" (size) Plastic (material)
- (6) pump 1 HP 10
 (HP) (yield gpm)
Electric (type power)
- (7) electric log No
 (yes or no)

(organization running log)

(8) how well bottom plugged FW Valve

DRILLERS REMARKS:


DEPT. OF NATURAL RESOURCES
 BUREAU OF LAND & WATER RESOURCES

NOV 21 1979

RECEIVED

If well telescopes please sketch and show depths.

GROUND LEVEL

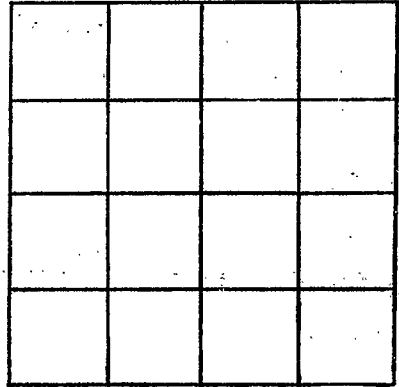

SECTION _____

Please indicate well location X.

ADDITIONAL INFORMATION

If more than one screen,
show locations of each on sketch.