

MARION

MISSISSIPPI  
BOARD OF WATER COMMISSIONERS  
416 North State Street  
Jackson, Mississippi 39201

G 2014

WATER WELL DRILLERS LOG

4-18-80

4-18  
date well completed

1980 Hollinsca  
firm name

MARION  
county well located

LANDOWNER: Malvin McGee  
RT 1  
Foxworth, Ms. 39483  
(mailing address)

| Description of formations encountered | from | to |
|---------------------------------------|------|----|
| Sand, chalk                           | 0    | 20 |
| Clay gravel                           | 20   | 55 |
| Sand, gravel                          | 55   | 67 |

WELL LOCATION:  
sec. 36 T. 4 N. R. 18 E. 18W  
S  
W  
2 miles N of Foxworth  
(distance) (direction) (nearest town)

WELL PURPOSE: Home  
(home, irrigation, municipal, industrial)

WELL COMPLETION DATA:

- (1) diameter (inches) 2
- (2) total depth (feet) 67
- (3) static water level (feet) 77 below top of ground.
- (4) casing PVC (material) (depth)
- (size) if telescope see back.
- (5) screen 5 62 (length) (depth to top)
- 2 PVC (size) (material)
- (6) pump 1 8 (HP) (yield gpm)
- elect (type power)
- (7) electric log (yes or no)

(organization running log)

(8) how well bottom plugged sand  
streak

DRILLERS REMARKS: good well


DEPT. OF NATURAL RESOURCES  
BUREAU OF LAND & WATER RESOURCES

JUL 21 1980

RECEIVED

If well telescopes please sketch and show depths.

GROUND LEVEL

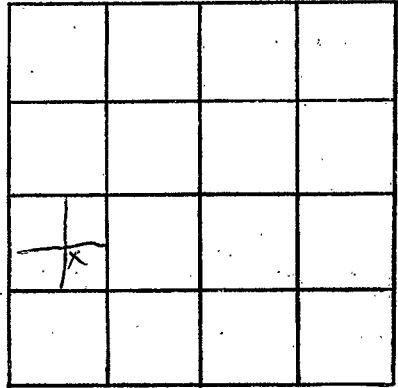

SECTION 36

Please indicate well location X.

ADDITIONAL INFORMATION

If more than one screen, show locations of each on sketch: