

MARION
G 2015
9-17-81

MISSISSIPPI
BOARD OF WATER COMMISSIONERS
416 North State Street
Jackson, Mississippi 39201

WATER WELL DRILLERS LOG

9-17-81

Tom Griffin, Inc. Water Well Marion

date well completed

firm name

county well located

LANDOWNER:
T. Z. Hoot Gibson
S.D. City Columbia, Miss
(mailing address)

description of formations encountered

from to

18 4 N 18 E
3 miles North of Columbia
(distance) (direction) (nearest town)

Topsoil 0 1
Chalk 1 19
Sand & Gravel 19 28
Blue Chalk 28 140
Sand 140 200

WELL LOCATION:

sec. 18 T. 4 N R. 18 E
3 miles North of Columbia
(distance) (direction) (nearest town)

WELL PURPOSE: Home
(home, irrigation, municipal, industrial)

WELL COMPLETION DATA:

- (1) diameter (inches) 4"
- (2) total depth (feet) 200'
- (3) static water level (feet) 100' below top of ground
- (4) casing Plastic, 200' (material) (depth)
4" (size) If telescope see back.
- (5) screen 20' 180' (length) (depth to top)
4" PVC (size) (material)
- (6) pump 1 (HP) 70 (yield gpm)
Elec (type power)
- (7) electric log NO (yes or no)
NONE (organization running log)

(8) how well bottom plugged B.W.

DRILLERS REMARKS:


DEPT. OF NATURAL RESOURCES
BUREAU OF LAND & WATER RESOURCES

OCT 20 1981

RECEIVED

If well telescopes please sketch and show depths.

GROUND LEVEL

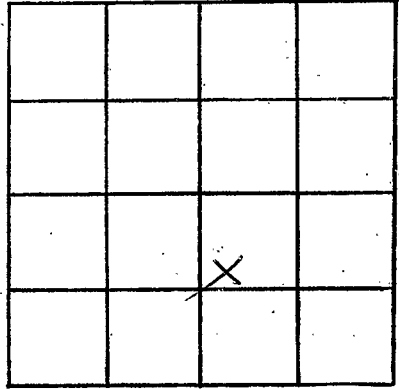

SECTION 18

Please indicate well location X.

ADDITIONAL INFORMATION

If more than one screen, show locations of each on sketch.