

Marion
G
2016

MISSISSIPPI
BOARD OF WATER COMMISSIONERS.
416 North State Street
Jackson, Mississippi 39201

WATER WELL DRILLERS LOG

5-27-82
date well completed

TOM GRIFFITH
PLUMBING
firm name SERVICE, INC.
300 WASHINGTON AVE
COLUMBIA, MISS 39202

Marion
county well located

LANDOWNER:	description of formations encountered	from	to
Tom Singler (mailing address)	0-165 sand pea shovel		
WELL LOCATION: sec 34 T 4 N S R 18 E Columbia (distance) miles (direction) of (nearest town)			
WELL PURPOSE: (home, irrigation, municipal, industrial)			
WELL COMPLETION DATA:			
(1) diameter (inches) 4"			
(2) total depth (feet) 165 ft			
(3) static water level (feet) 98 below top of ground.			
(4) casing (material) (depth) 145			
(size) if telescope see back.			
(5) screen (length) (depth to top) 20' 145			
(size) (material) 4" PVC			
(6) pump (HP) (yield gpm) 1 20			
(type power)			
(7) electric log (yes or no)			
(organization running log) BWD			
(8) how well bottom plugged			
DRILLERS REMARKS:			


DEPT. OF NATURAL RESOURCES
BUREAU OF LAND & WATER RESOURCES

JUN 25 1982

RECEIVED

If well telescopes please sketch and show depths.

GROUND LEVEL

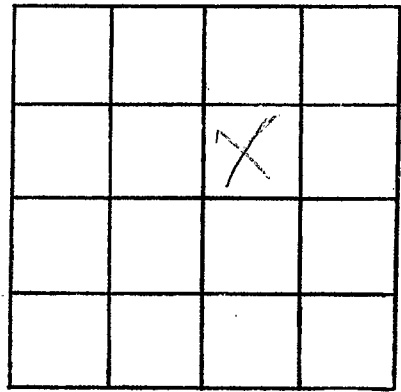

SECTION _____

Please indicate well location X.

ADDITIONAL INFORMATION

Lined area for additional information.

If more than one screen, show locations of each on sketch.