

MISSISSIPPI DEPARTMENT OF NATURAL RESOURCES

Bureau of Land and Water Resources

Southport Mall

P.O. Box 10631

Jackson, Mississippi 39209

WATER WELL DRILLERS LOG

Merion
G
2017

9-2 1982
 date well completed

Hollinger
 firm name

Merion
 county well located

LANDOWNER:	description of formations encountered	from	to
<u>Frane Haddock</u>			
<u>Hospital Rd.</u>			
<u>Columbia, MS</u> (mailing address)	<u>CLAY, sand</u>	<u>0</u>	<u>30</u>
	<u>sand gravel</u>	<u>30</u>	<u>50</u>
	<u>per gravel</u>	<u>50</u>	<u>87</u>
WELL LOCATION:			
sec. <u>33</u> T. <u>4</u> (N) S. R. <u>18</u> (E) W.			
<u>2</u> miles <u>E</u> of <u>Columbia</u> (distance) (direction) (nearest town)			
WELL PURPOSE: (home, irrigation, municipal, industrial)			
WELL COMPLETION DATA:			
(1) diameter (inches) <u>2</u>			
(2) total depth (feet) <u>87</u>			
(3) static water level (feet) <u>40</u> (below/above top of ground)			
(4) casing <u>PVC</u> , <u>82</u> (material) (depth)			
_____ if telescope see back. (size)			
(5) screen <u>5</u> , <u>82</u> (length) (depth to top)			
<u>2</u> , <u>PVC</u> (size) (material)			
(6) pump <u>1</u> , <u>8</u> (HP) (yield gpm)			
<u>elect</u> (type power)			
(7) electric log _____ (yes or no)			
_____ (organization running log)			
(8) how well bottom plugged <u>SAND</u> <u>SHOR K</u>			
DRILLERS REMARKS: <u>good well</u>			


DEPT. OF NATURAL RESOURCES
 BUREAU OF LAND & WATER RESOURCES

NOV 16 1982

RECEIVED

If well telescopes please sketch and show depths.

GROUND LEVEL

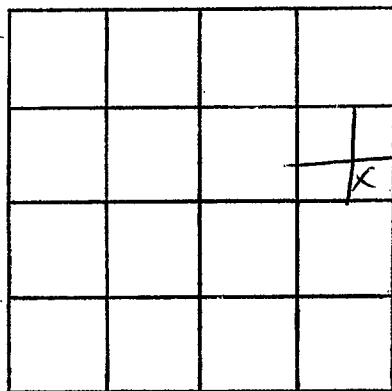

SECTION 33

Please indicate well location X.

ADDITIONAL INFORMATION

If more than one screen,
show locations of each on sketch.