

Marion
G

MISSISSIPPI
BOARD OF WATER COMMISSIONERS
416 North State Street
Jackson, Mississippi 39201

WATER WELL DRILLERS LOG

TOM GRIFFITH
PLUMBING & WELL SERVICE, INC.
320 MAYSON AVE.
COLUMBIA, MS 39429

Marion
county well located

2019
11/16/83
date well completed

LANDOWNER: John Whitfield

description of formations encountered

from to

Rt. 1

Columbia, MS.
(mailing address)

Clay
Sand

1' 55'
55' 100'

WELL LOCATION:

sec. 11 T 46 N R 18 E
S W
10 miles NE of Columbia
(distance) (direction) (nearest town)

WELL PURPOSE: Farm
(home, irrigation, municipal, industrial)

WELL COMPLETION DATA:

- (1) diameter (inches) 2"
- (2) total depth (feet) 100
- (3) static water level (feet) 20' below top of ground.
- (4) casing PVC 80'
(material) (depth)
- n/a if telescope see back.
(size)
- (5) screen 20' 80'
(length) (depth to top)
- 2" PVC
(size) (material)
- (6) pump 1 10
(HP) (yield gpm)
- Elec
(type power)
- (7) electric log no
(yes or no)
- n/a
(organization running log)
- (8) how well bottom plugged B.O.V.

DEPT. OF NATURAL RESOURCES
BUREAU OF LAND & WATER RESOURCES


DRILLERS REMARKS:

FEB 16 1984

RECEIVED

If well telescopes please sketch and show depths.

GROUND LEVEL

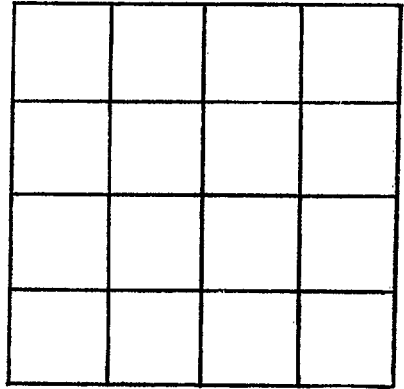

SECTION _____

Please indicate well location X.

ADDITIONAL INFORMATION

If more than one screen,
show locations of each on sketch.