

Marion
G
2020

MISSISSIPPI DEPARTMENT OF NATURAL RESOURCES

Bureau of Land and Water Resources

Southport Mall

P.O. Box 10631

Jackson, Mississippi 39209

WATER WELL DRILLERS LOG

TOM GRIFFITH

PLUMBING & WELL SERVICE, INC.

firm name

320 MAYSON AVE.

county well located

4-23 19 84
 date well completed

Marion

LANDOWNER: Henry Bardwell, Jr.
115 Marion Ave.
Columbia, MS 39429
 (mailing address)

description of formations encountered	from	to
<u>Red Sand</u>	<u>1'</u>	<u>10'</u>
<u>Clay</u>	<u>10'</u>	<u>15'</u>
<u>Sand</u>	<u>15'</u>	<u>45'</u>
<u>Clay</u>	<u>45'</u>	<u>280'</u>
<u>Sand</u>	<u>280'</u>	<u>345'</u>

WELL LOCATION:
 sec. 6 T 40 N R 18 E
3 miles E of Goss
 (distance) (direction) (nearest town)

WELL PURPOSE: Home
 (home, irrigation, municipal, industrial)

- WELL COMPLETION DATA:
- (1) diameter (inches) 4"
 - (2) total depth (feet) 345'
 - (3) static water level (feet) 190' below above top of ground.
 - (4) casing PVC, 325'
 (material) (depth)
N/A if telescope see back.
 (size)
 - (5) screen 20', 325' 325'
 (length) (depth to top)
4", PVC
 (size) (material)
 - (6) pump 3/4, 12
 (HP) (yield gpm)
elec.
 (type power)
 - (7) electric log N/A
 (yes or no)
N/A
 (organization running log)
 - (8) how well bottom plugged BWV


DRILLERS REMARKS:

DEPT. OF NATURAL RESOURCES
 BUREAU OF LAND & WATER RESOURCES

MAY - 2 1984
 RECEIVED

If well telescopes please sketch and show depths.

GROUND LEVEL

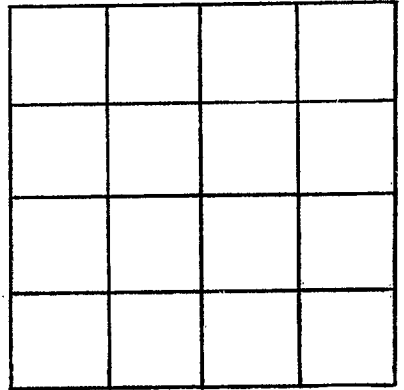

SECTION _____

Please indicate well location X.

ADDITIONAL INFORMATION

If more than one screen,
show locations of each on sketch.