

MISSISSIPPI DEPARTMENT OF NATURAL RESOURCES

Bureau of Land and Water Resources

Southport Mall

P.O. Box 10631

Jackson, Mississippi 39209

WATER WELL DRILLERS LOG

*Marion*  
 B 2001

11-14 1984  
 date well completed

Hollinson  
 firm name

Marion  
 county well located

LANDOWNER: *Tim Melchea*

description of formations encountered

from

to

*Hwy 35 N Teen Road*

*sand, chalk*

*0*

*10*

*Columbia, MS*

*sand, gravel*

*10*

*50*

(mailing address)

*chalk*

*50*

*240*

*pen gravel*

*240*

*290*

WELL LOCATION:

sec. *17* T-*4* (N) R-*18* E  
*6* miles *SW* of *Columbia*  
 (distance) (direction) (nearest town)

WELL PURPOSE:

(home, irrigation, municipal, industrial)

WELL COMPLETION DATA:

- (1) diameter (inches) *4"*
- (2) total depth (feet) *290*
- (3) static water level (feet) *80* below above  
 top of ground.

- (4) casing *PVC*, *290*  
 (material) (depth)

if telescope see back.  
 (size)

- (5) screen *10*, *290*  
 (length) (depth to top)

*4*, *PVC*  
 (size) (material)

- (6) pump *2*, *11*  
 (HP) (yield gpm)

*elect.*  
 (type power)

- (7) electric log \_\_\_\_\_  
 (yes or no)

\_\_\_\_\_  
 (organization running log)

- (8) how well bottom plugged *sand*  
*SHANK*

DRILLERS REMARKS: *Very good well*


DEPT. OF NATURAL RESOURCES  
 BUREAU OF LAND & WATER RESOURCES

NOV 20 1984

RECEIVED

If well telescopes please sketch and show depths.

GROUND LEVEL

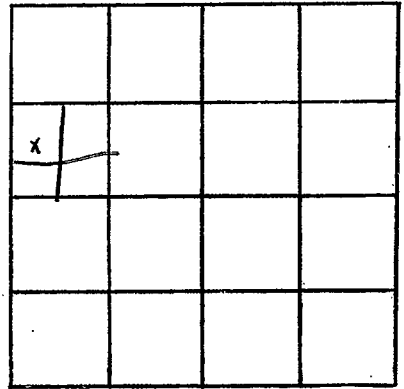

SECTION 17

Please indicate well location X.

ADDITIONAL INFORMATION

If more than one screen,  
show locations of each on sketch.