

MISSISSIPPI DEPARTMENT OF NATURAL RESOURCES

Bureau of Land and Water Resources

Southport Mall

P.O. Box 10631

Jackson, Mississippi 39209

WATER WELL DRILLERS LOG

MARION
G 2022

6-20- 19 85 Hollinsek MARION
 date well completed firm name county well located


LANDOWNER:	description of formations encountered	from	to
J. J. Honey P.O. Box 725 Columbia (mailing address)			
WELL LOCATION: sec. <u>21</u> T- <u>4</u> N R- <u>18</u> E S W <u>3</u> miles <u>N</u> of <u>Columbia</u> (distance) (direction) (nearest town)			
WELL PURPOSE: (home, irrigation, municipal, <u>industrial</u>)			
WELL COMPLETION DATA: (1) diameter (inches) <u>4"</u> (2) total depth (feet) <u>100</u> (3) static water level (feet) <u>30</u> <u>below</u> above top of ground. (4) casing <u>PVC</u> <u>90</u> (material) (depth) _____ if telescope see back. (size) (5) screen <u>10</u> <u>90</u> (length) (depth to top) <u>4</u> <u>PVC</u> (size) (material) (6) pump <u>1</u> <u>12</u> (HP) (yield gpm) <u>elect</u> (type power) (7) electric log _____ (yes or no) _____ (organization running log) (8) how well bottom plugged <u>SAND</u> <u>SHAKK</u>			
DRILLERS REMARKS: <u>good well</u>			

RECEIVED
AUG 15 1985

Department of Natural Resources
Bureau of Land & Water Resources

If well telescopes please sketch and show depths.

GROUND LEVEL

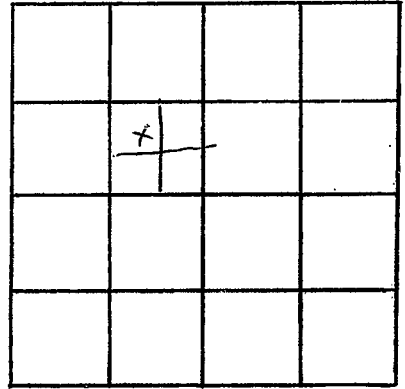

SECTION 21

Please indicate well location X.

ADDITIONAL INFORMATION

If more than one screen,
show locations of each on sketch.